


Capabilities on project:  
Transportation

## 7 Appendices

### Appendix A - Relevant Statutory Undertakers Drawings

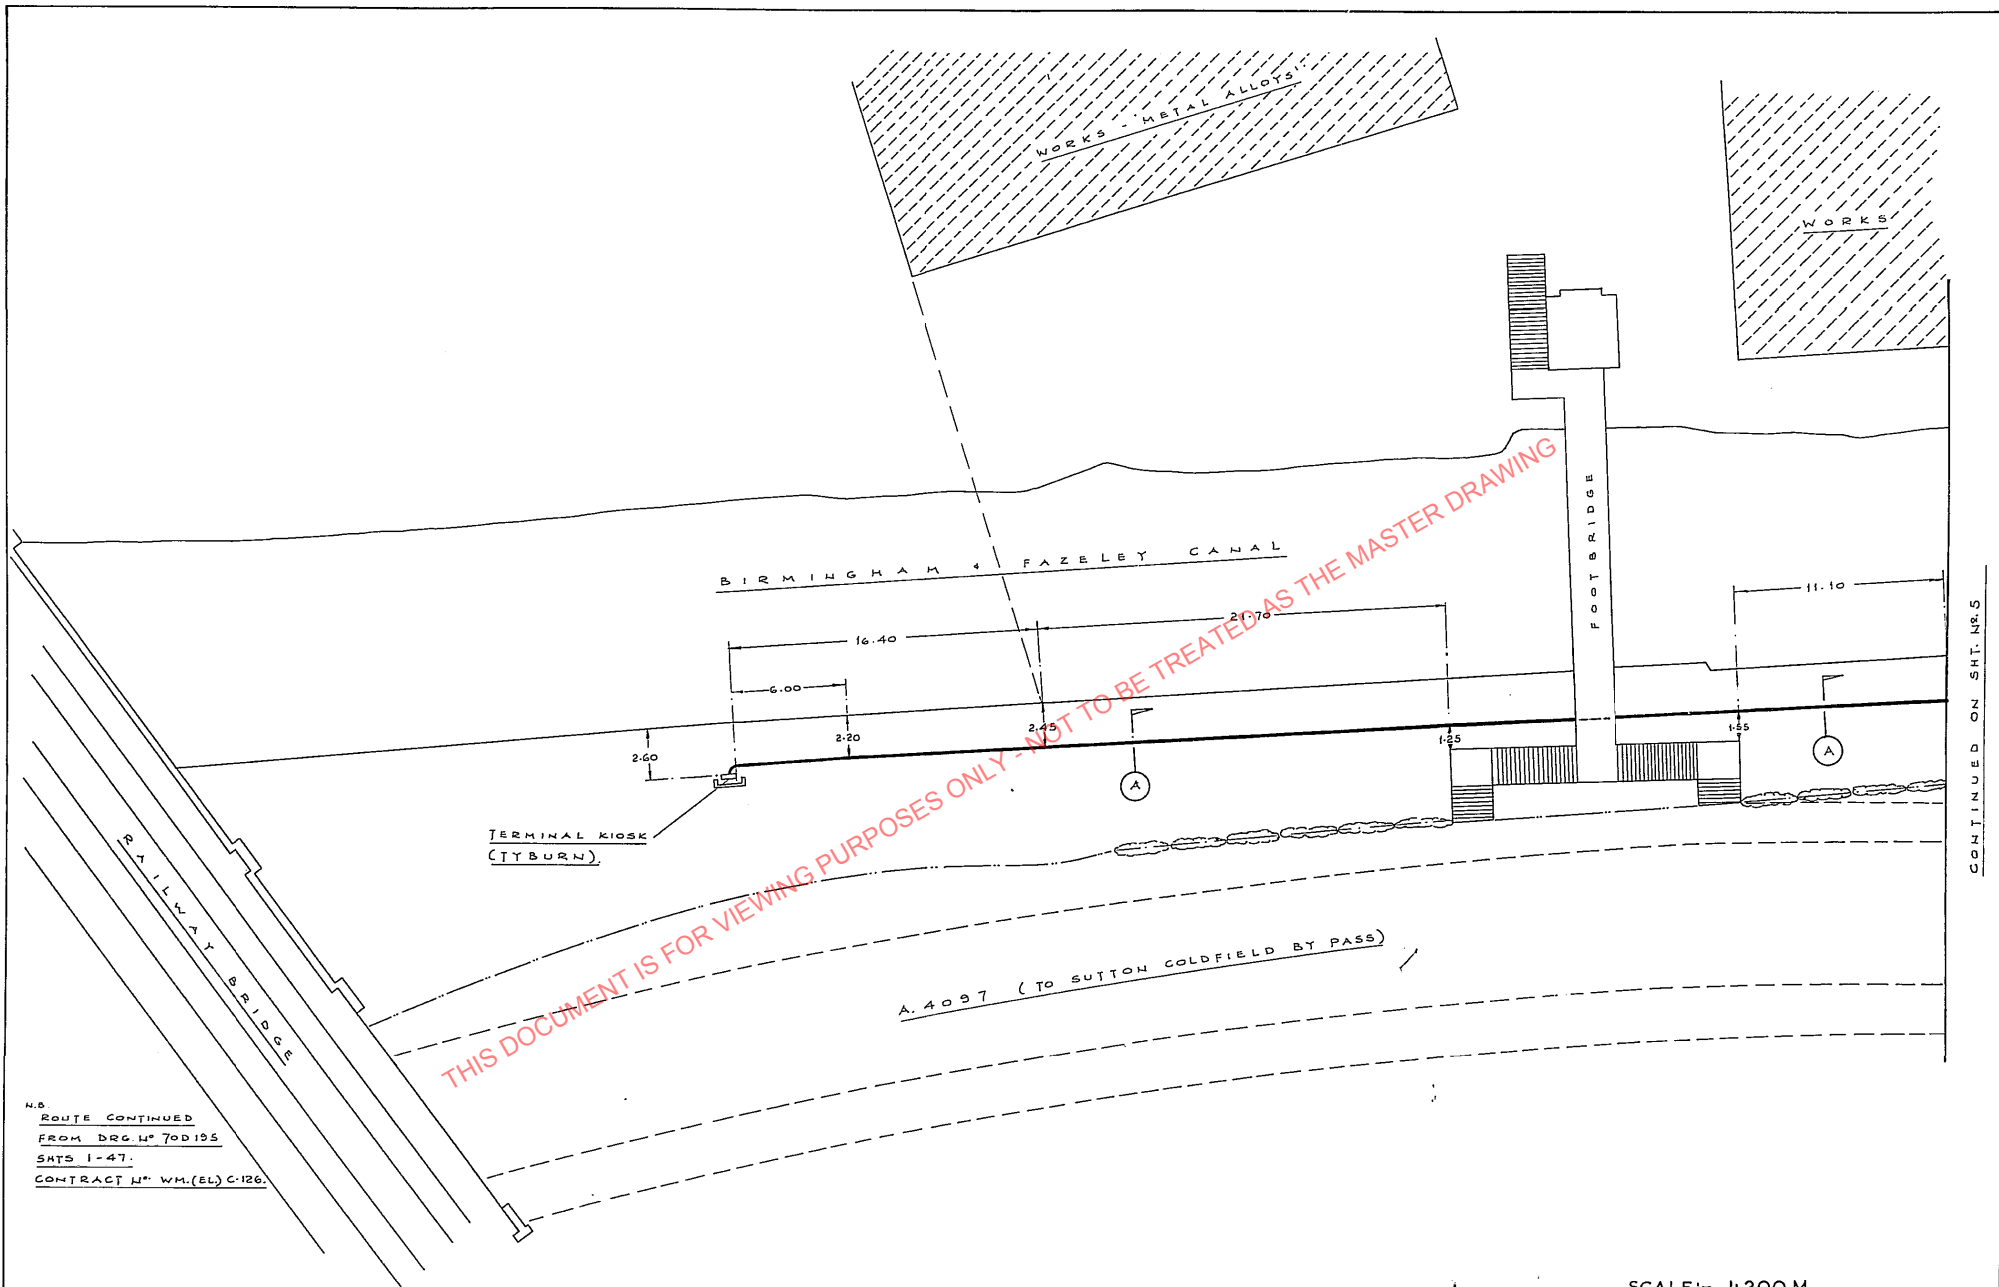

N.B.  
 ROUTE CONTINUED  
 FROM DRG. No. 70D195  
 SHTS 1-47.  
 CONTRACT No. WM.(EL) C-126.

CONTINUED ON SHT. No. 5


BALFOUR KILPATRICK  
 INSTALLATIONS LTD.  
 DRG. No. M.D. 997.

ERDINGTON - HAMS HALL 'PA' PILOTS  
 SECTION 1: TYBURN - MINWORTH  
 CONTRACT No. 713/RT/EC/1052

SCALE:- 1:200 M.

CENTRAL ELECTRICITY GENERATING BOARD MIDLANDS REGION	
DRG. No. 70D364	
DATE SEPT '73	SHEET No 4 No OF SHEETS:- 16

70/16940 sht 4

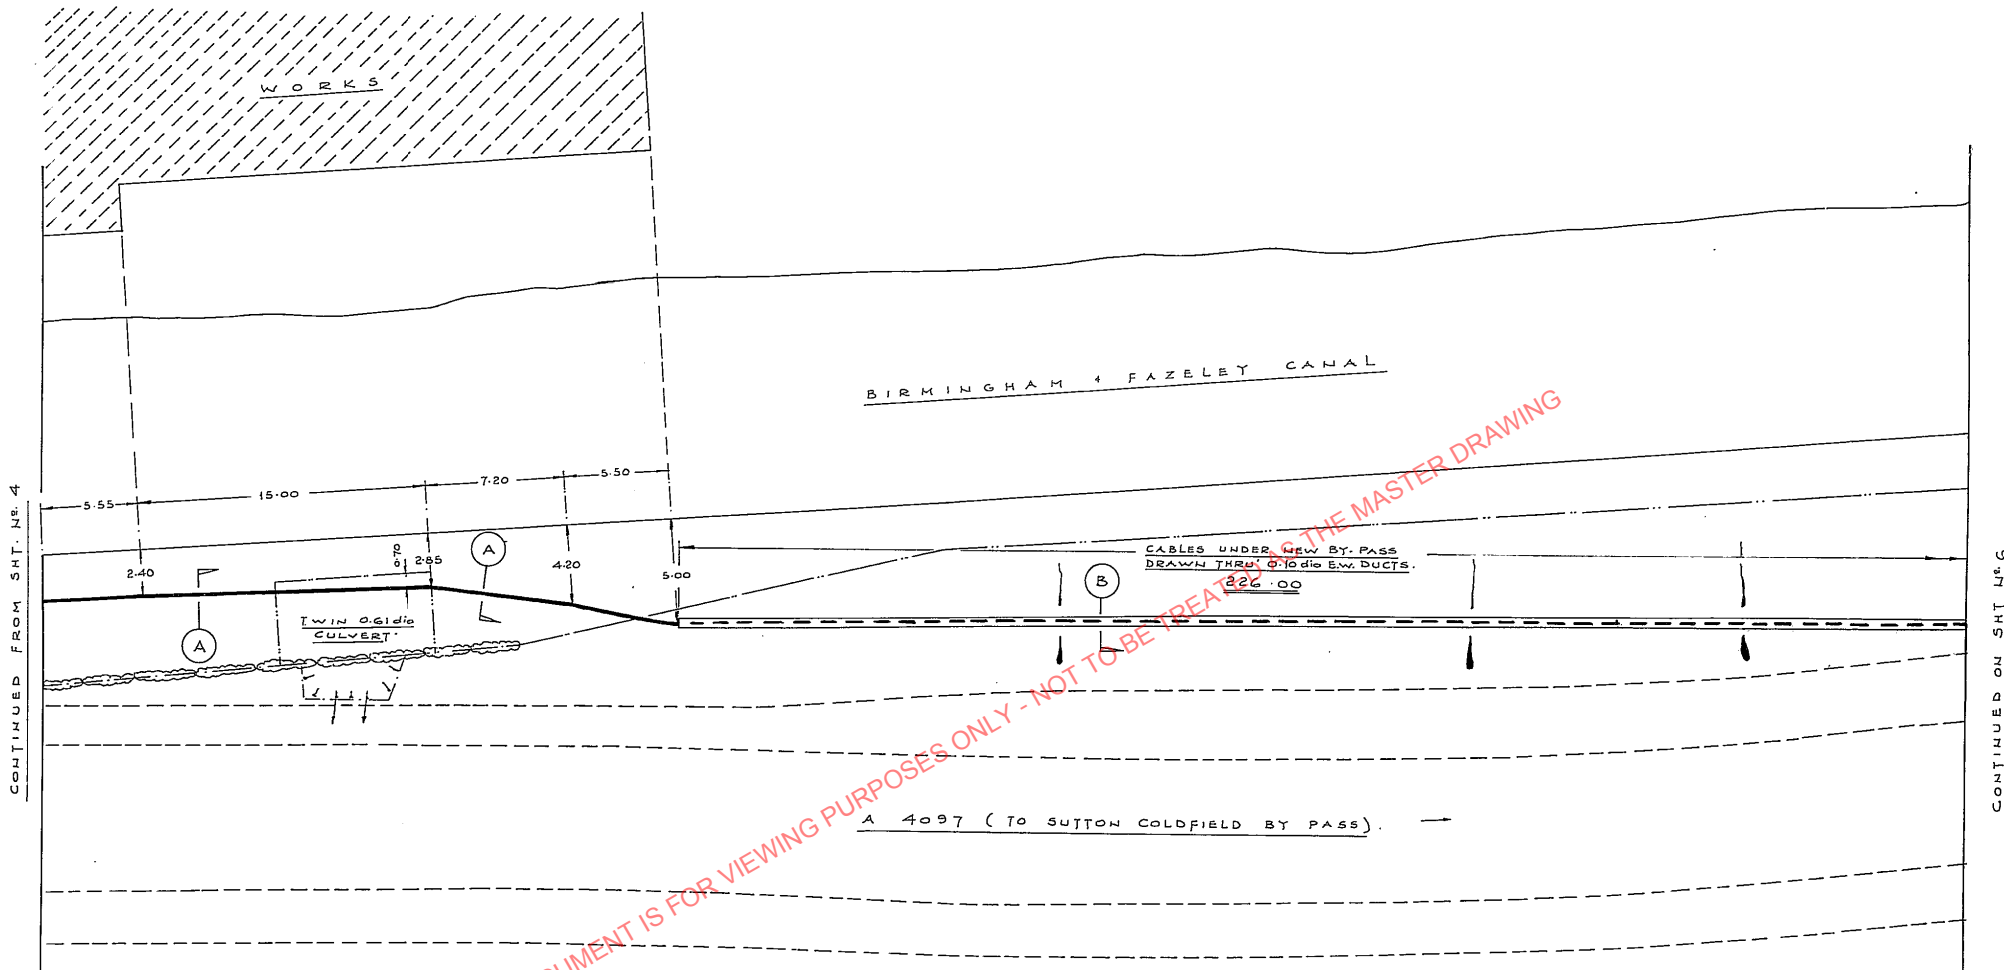


THIS DOCUMENT IS FOR VIEWING PURPOSES ONLY - NOT TO BE TREATED AS THE MASTER DRAWING

BALFOUR KILPATRICK  
INSTALLATIONS LTD.  
DRG. No. M.D. 997.

ERDINGTON - HAMS HALL 'PA' PILOTS  
SECTION I: TYBURN - MINWORTH  
CONTRACT N°713/RT/EC/1052

SCALE:- 1: 200 M.	
CENTRAL ELECTRICITY GENERATING BOARD MIDLANDS REGION	
DRG. No. 70D364	
DATE SEPT '73	SHEET No 5 No OF SHEETS:- 16

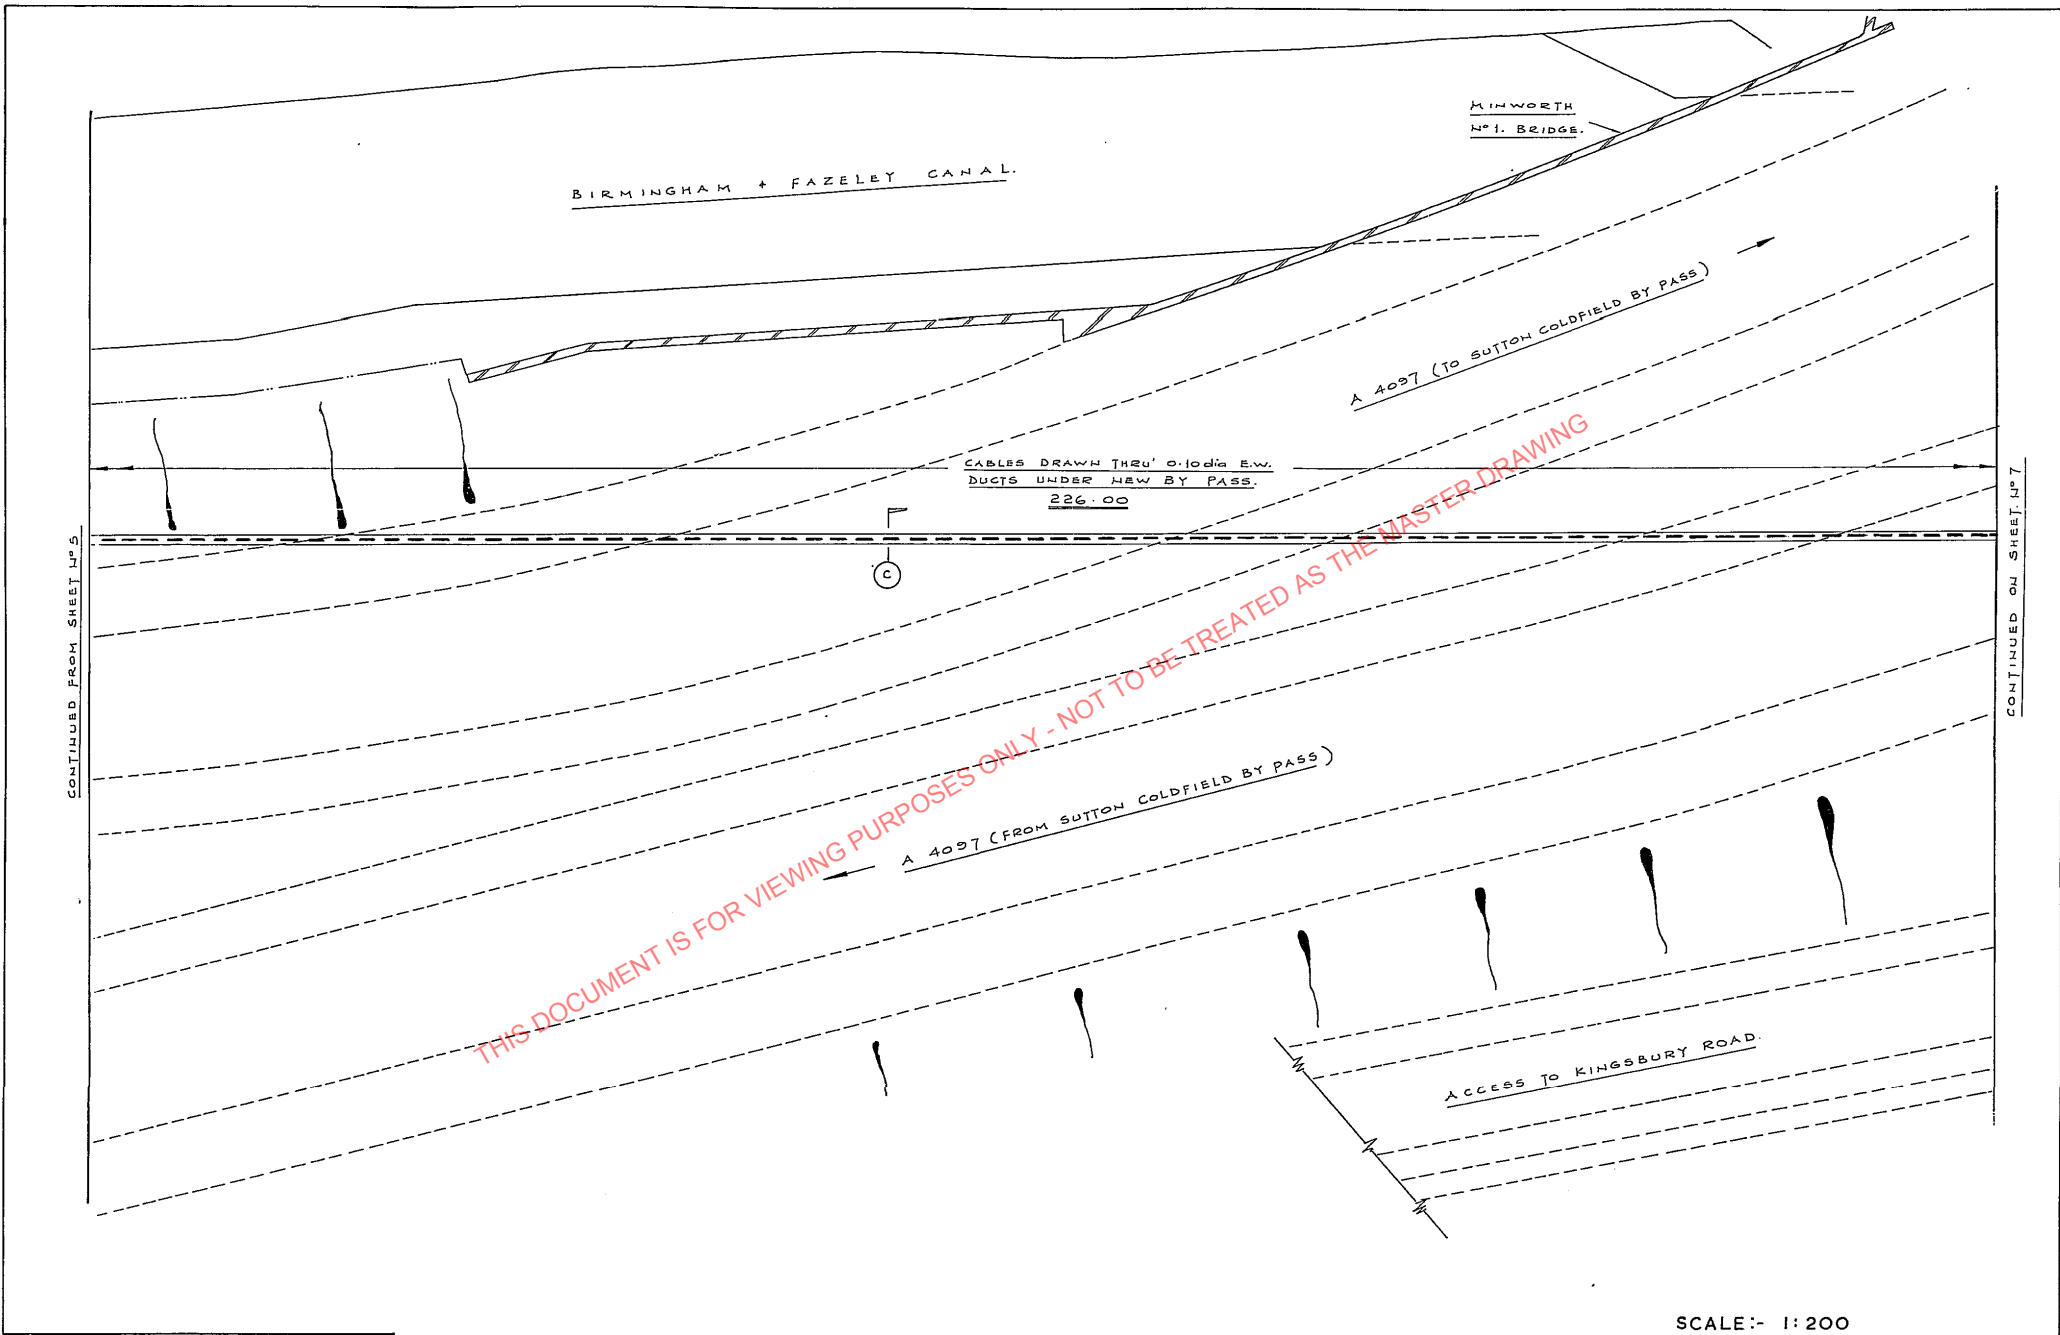


THIS DOCUMENT IS FOR VIEWING PURPOSES ONLY - NOT TO BE TREATED AS THE MASTER DRAWING

BALFOUR KILPATRICK  
 INSTALLATIONS LTD.  
 DRG. No. M.D. 997.

ERDINGTON - HAMS HALL 'PA' PILOTS  
 SECTION I.: TYBURN - MINWORTH  
 CONTRACT No 713/RT/EC/1052

SCALE:- 1:200  
 CENTRAL ELECTRICITY GENERATING BOARD  
 MIDLANDS REGION  
 DRG. No. 70D364  
 DATE SHEET '73 SHEET No 6  
 No OF SHEETS: 16

70/16940 sht 6

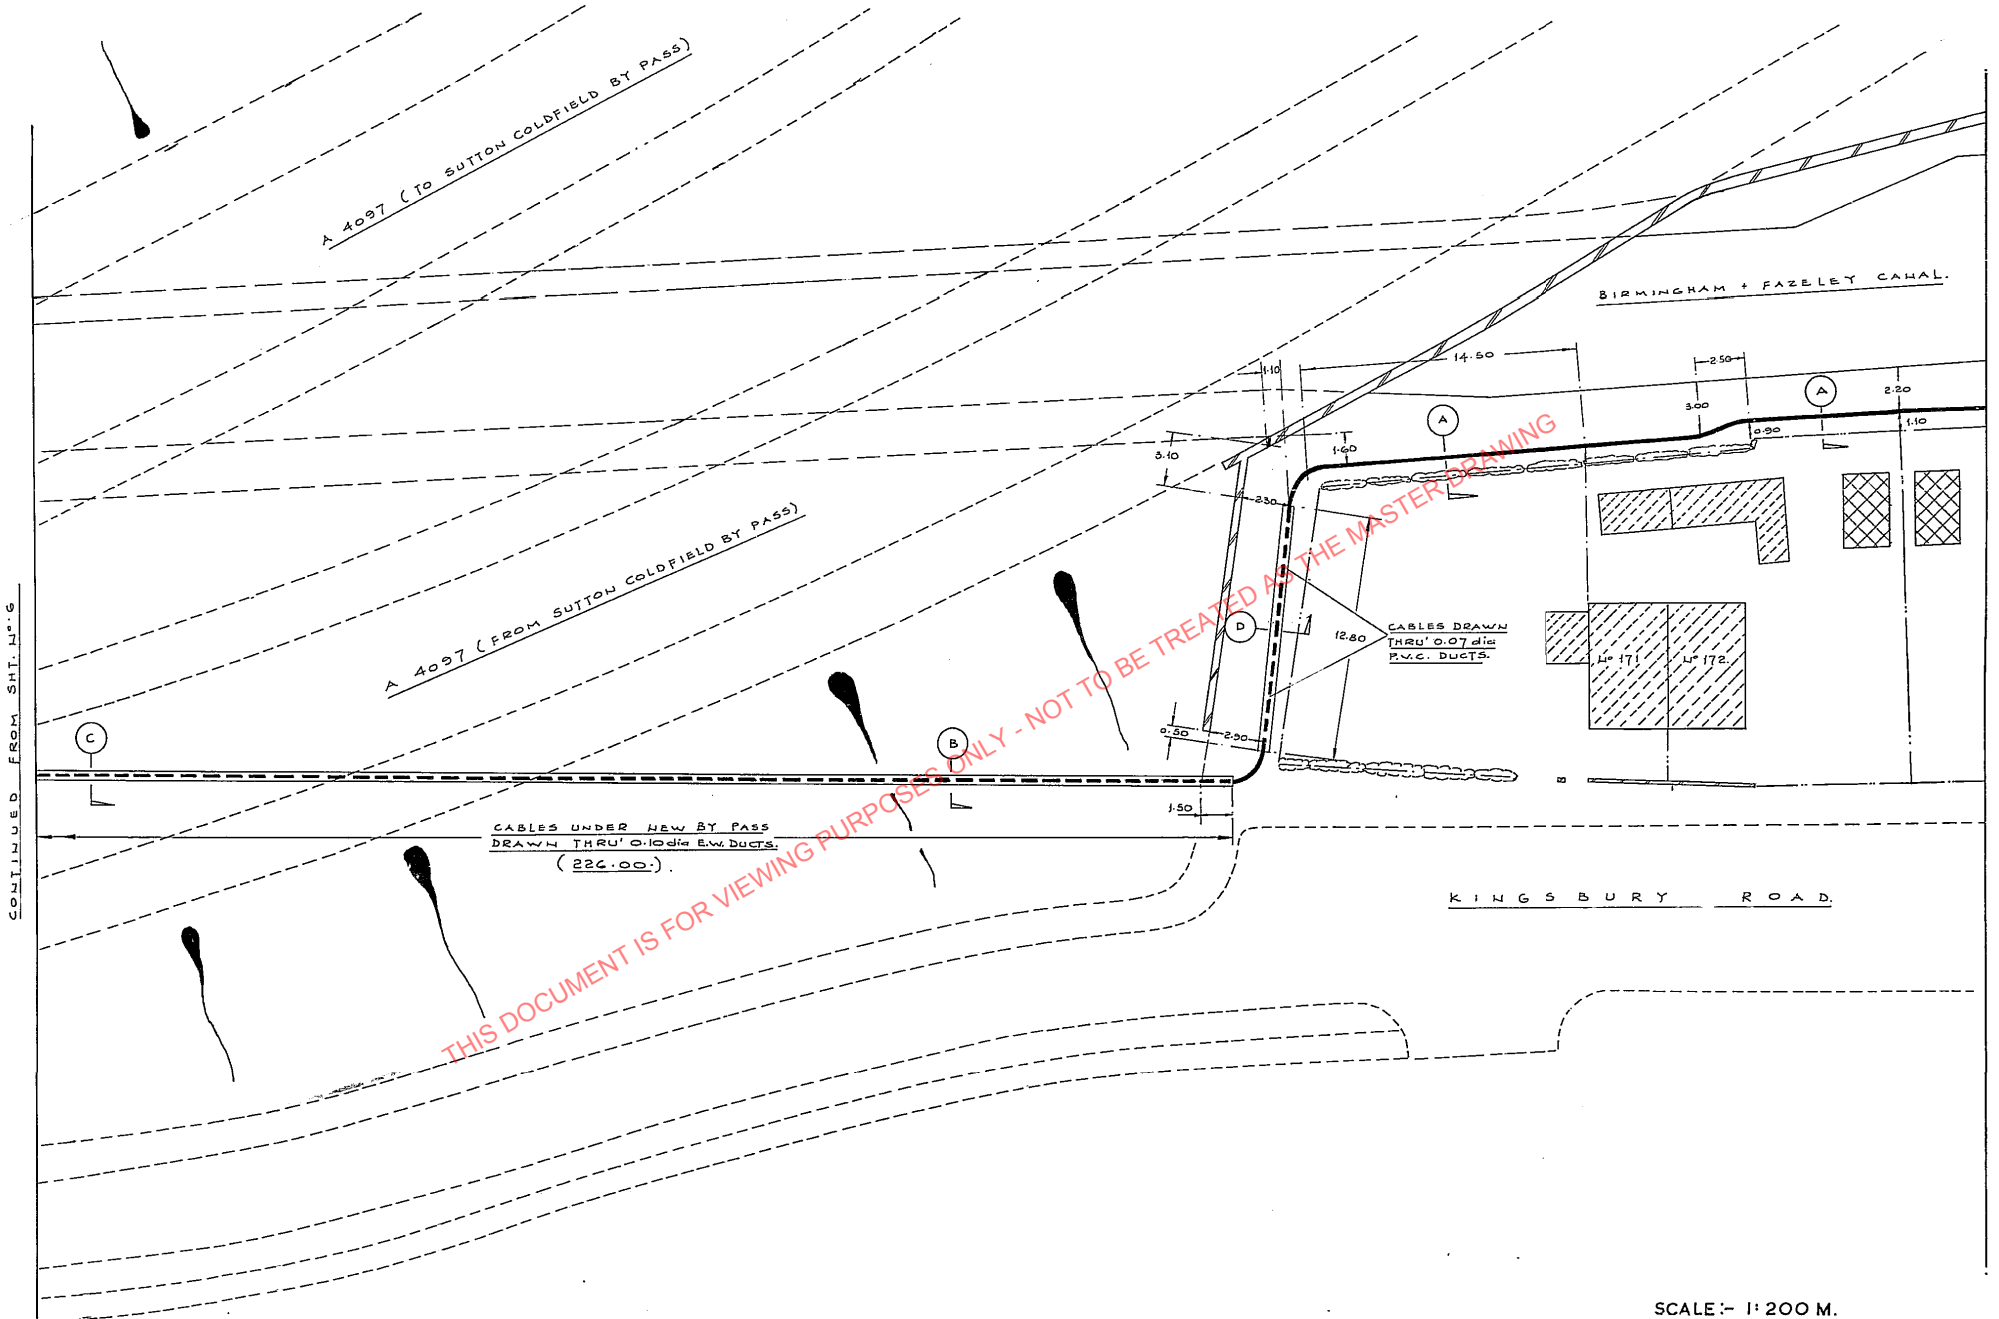

CONTINUED FROM SHIT. N° 6

CONTINUED ON SHIT. N° 8


BALFOUR KILPATRICK  
INSTALLATIONS LTD.  
DRG. N° M.D. 997.

ERDINGTON HAMS HALL 'PA' PILOTS  
SECTION I : TYBURN - MINWORTH  
CONTRACT N° 713/RT/EC/1052

SCALE :- 1:200 M.

CENTRAL ELECTRICITY GENERATING BOARD MIDLANDS REGION	
DRG. No. 70D364	
DATE SEPT '73	SHEET No 7 No OF SHEETS: 16

70/16940 st 7

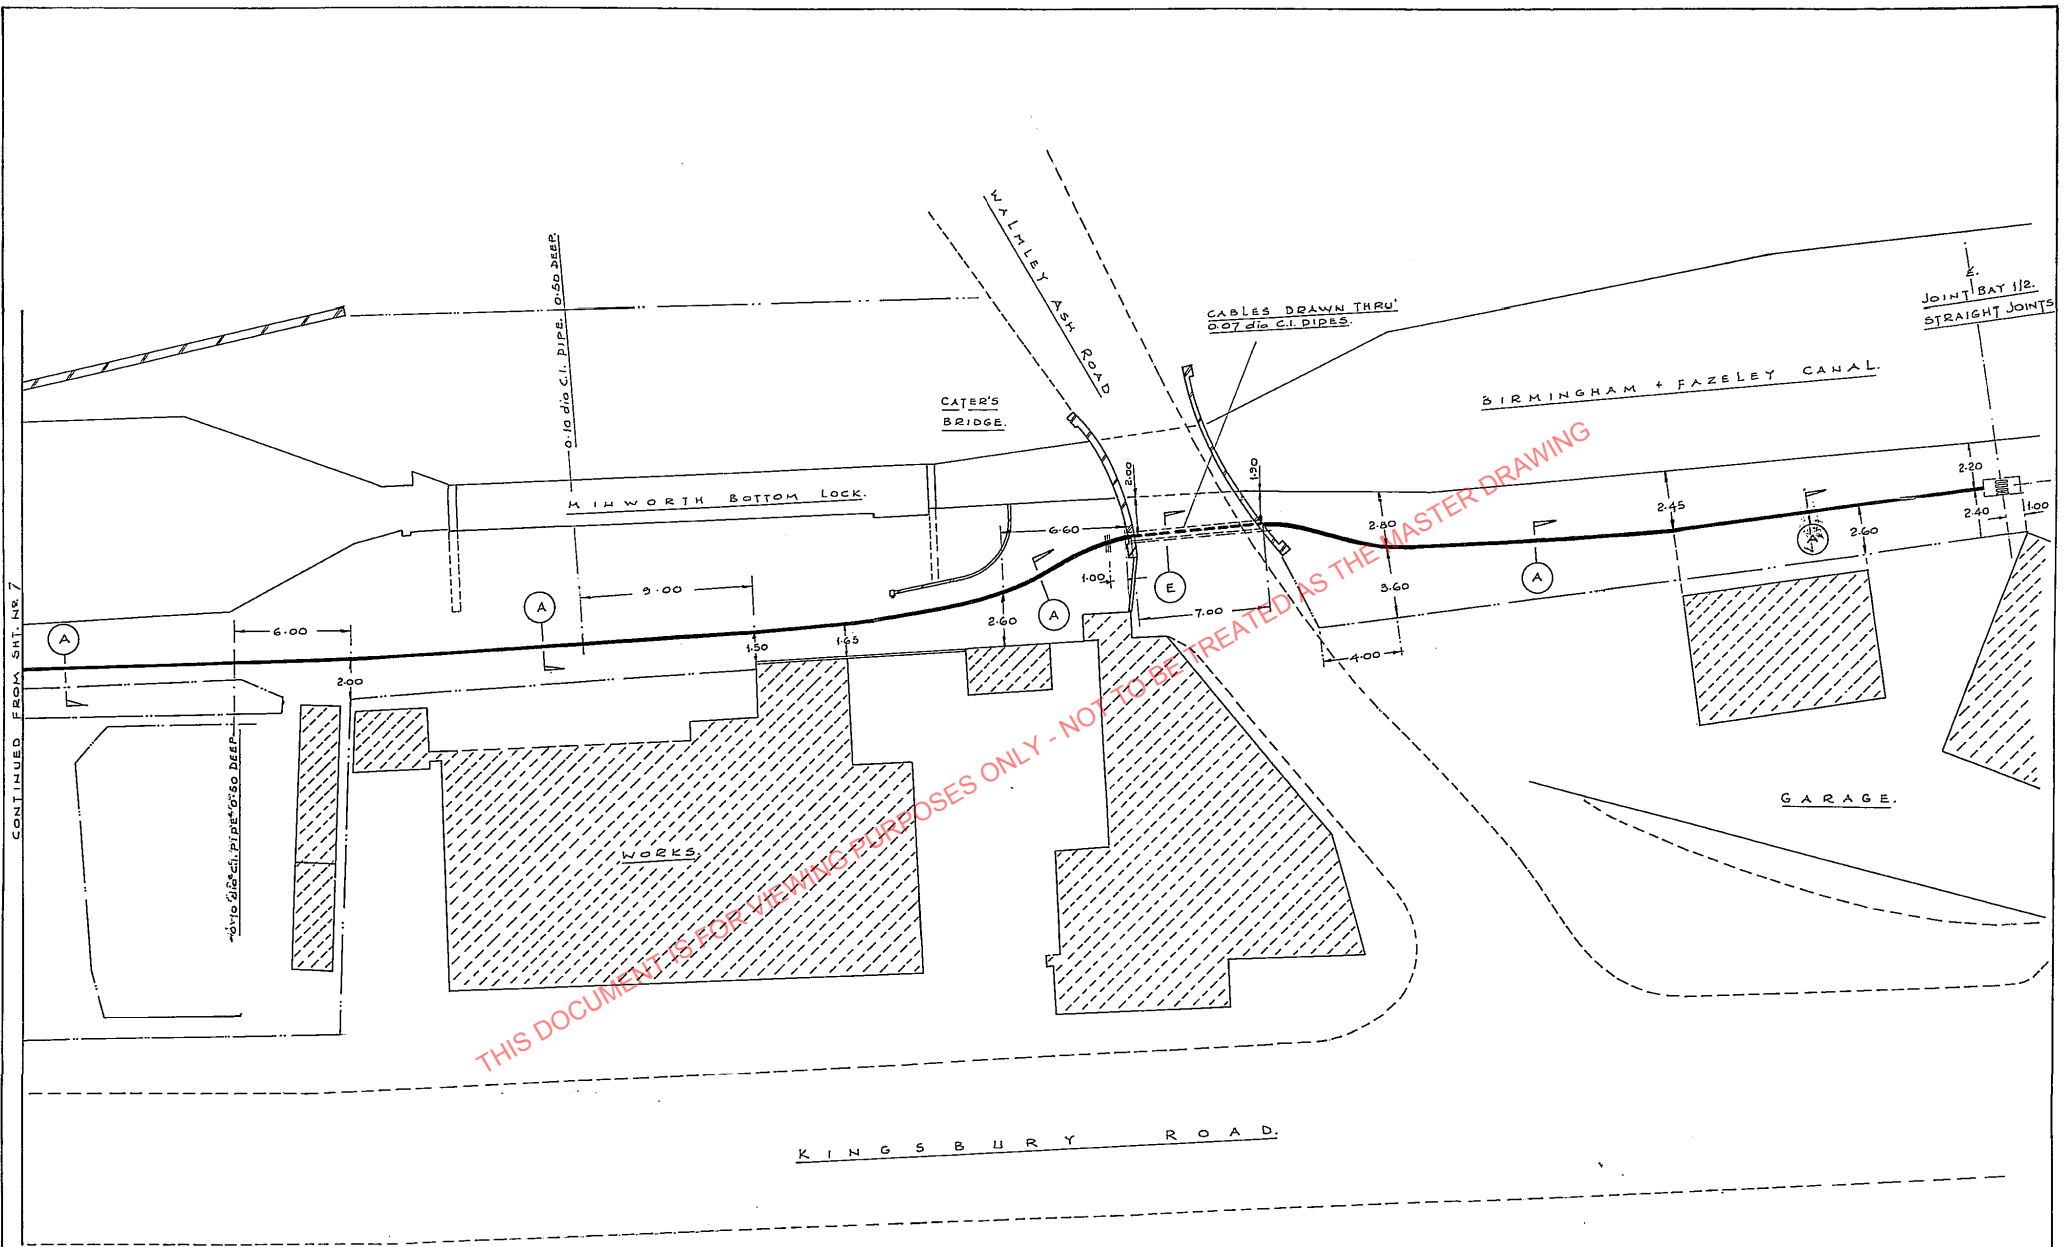

THIS DOCUMENT IS FOR VIEWING PURPOSES ONLY - NOT TO BE TREATED AS THE MASTER DRAWING






BALFOUR KILPATRICK  
INSTALLATIONS LTD.  
DRG. N<sup>o</sup> M.D. 997,

ERDINGTON - HAMS HALL 'PA' PILOTS  
SECTION I: TYBURN - MINWORTH  
CONTRACT N<sup>o</sup> 713/RT/EC/1052

SCALE: 1:200	
CENTRAL ELECTRICITY GENERATING BOARD MIDLANDS REGION	
DRG. N <sup>o</sup> 70D364	
DATE SEPT '73	SHEET N <sup>o</sup> 8 No OF SHEETS: 16

70/16940 sht 8

THIS DOCUMENT IS FOR VIEWING PURPOSES ONLY – NOT TO BE TREATED AS THE MASTER DRAWING

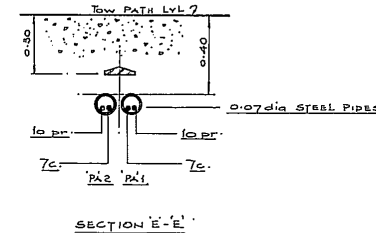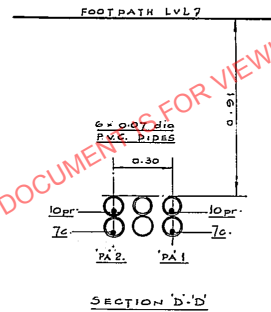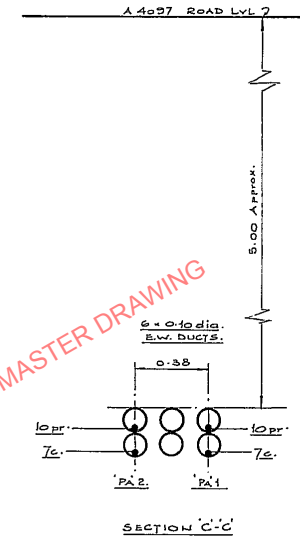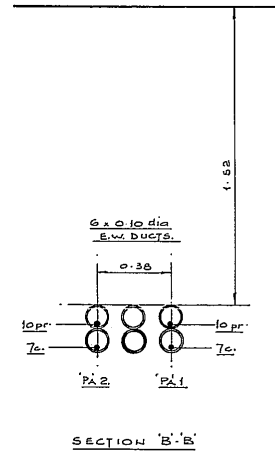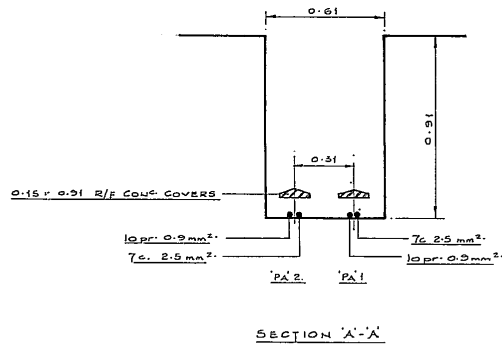

SECTIONS FACING MINWORTH.

THIS DOCUMENT IS FOR VIEWING PURPOSES ONLY - NOT TO BE TREATED AS THE MASTER DRAWING

BALFOUR KILPATRICK  
INSTALLATIONS LTD.

DRG.No. M.D. 997.

ERDINGTON HAMS HALL 'PA' PILOTS  
SECTION I : TYBURN - MINWORTH  
CONTRACT N° 713/RT/EC/1052

SCALE:- 1:20 M.

CENTRAL ELECTRICITY GENERATING BOARD  
MIDLANDS REGION


DRG.No. 70D364

DATE SHEET No9  
SERV '73 No OF SHEETS: 16

70/16940 sht 9

BIRMINGHAM & FAZELEY CANAL

JOINT-BAY 1/2  
STRAIGHT JOINTS

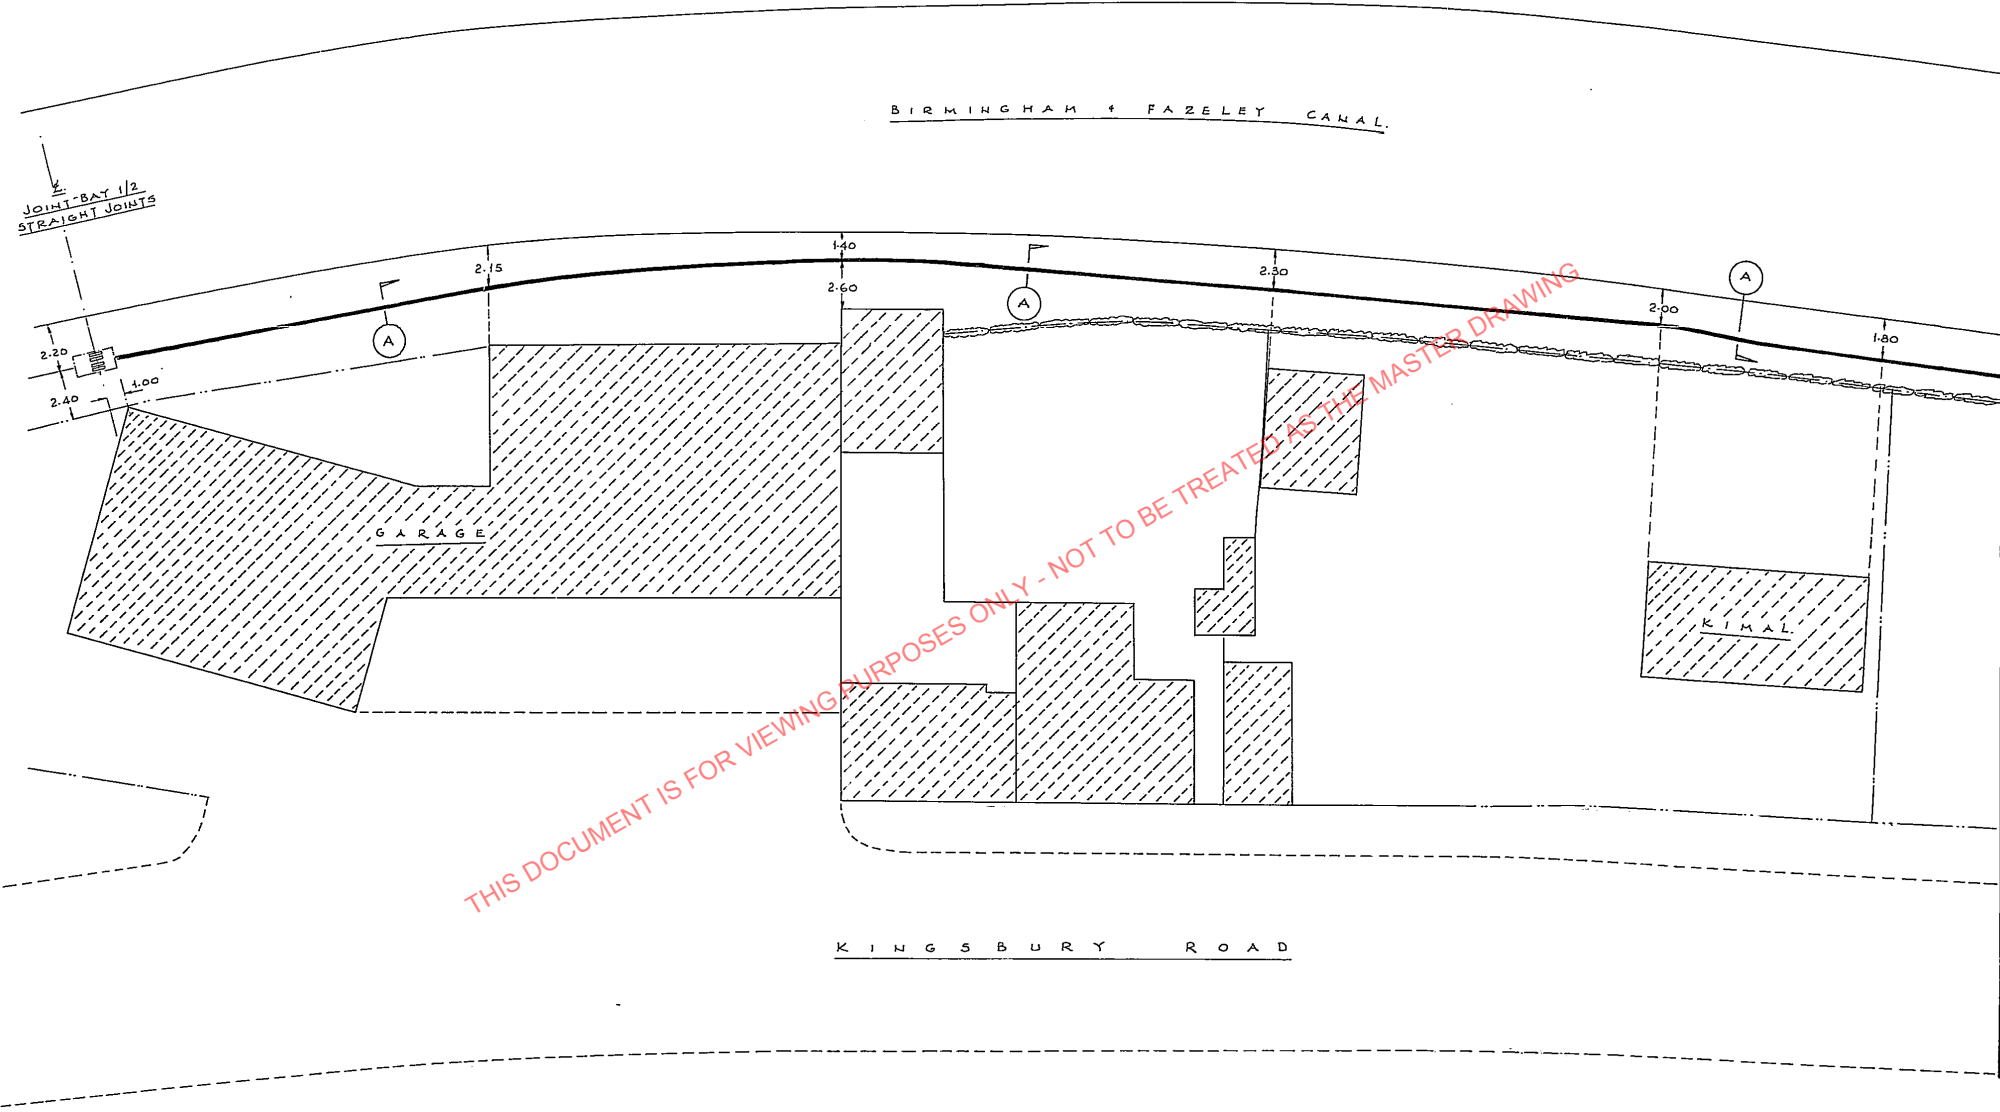

CONTINUED ON SMT. NR II

THIS DOCUMENT IS FOR VIEWING PURPOSES ONLY - NOT TO BE TREATED AS THE MASTER DRAWING

KINGSBURY ROAD

BALFOUR KILPATRICK  
INSTALLATIONS LTD.


DRG. No. M.D. 997

ERDINGTON - HAMS HALL 'PA' PILOTS  
SECTION 2: TYBURN - MINWORTH  
CONTRACT No 713/RT/EC/1052

SCALE: 1:200 M	
CENTRAL ELECTRICITY GENERATING BOARD MIDLANDS REGION	
DRG. No. 70D364	
DATE SEPT '73	SHEET No 10 No OF SHEETS: 16

70/16940 sht 10



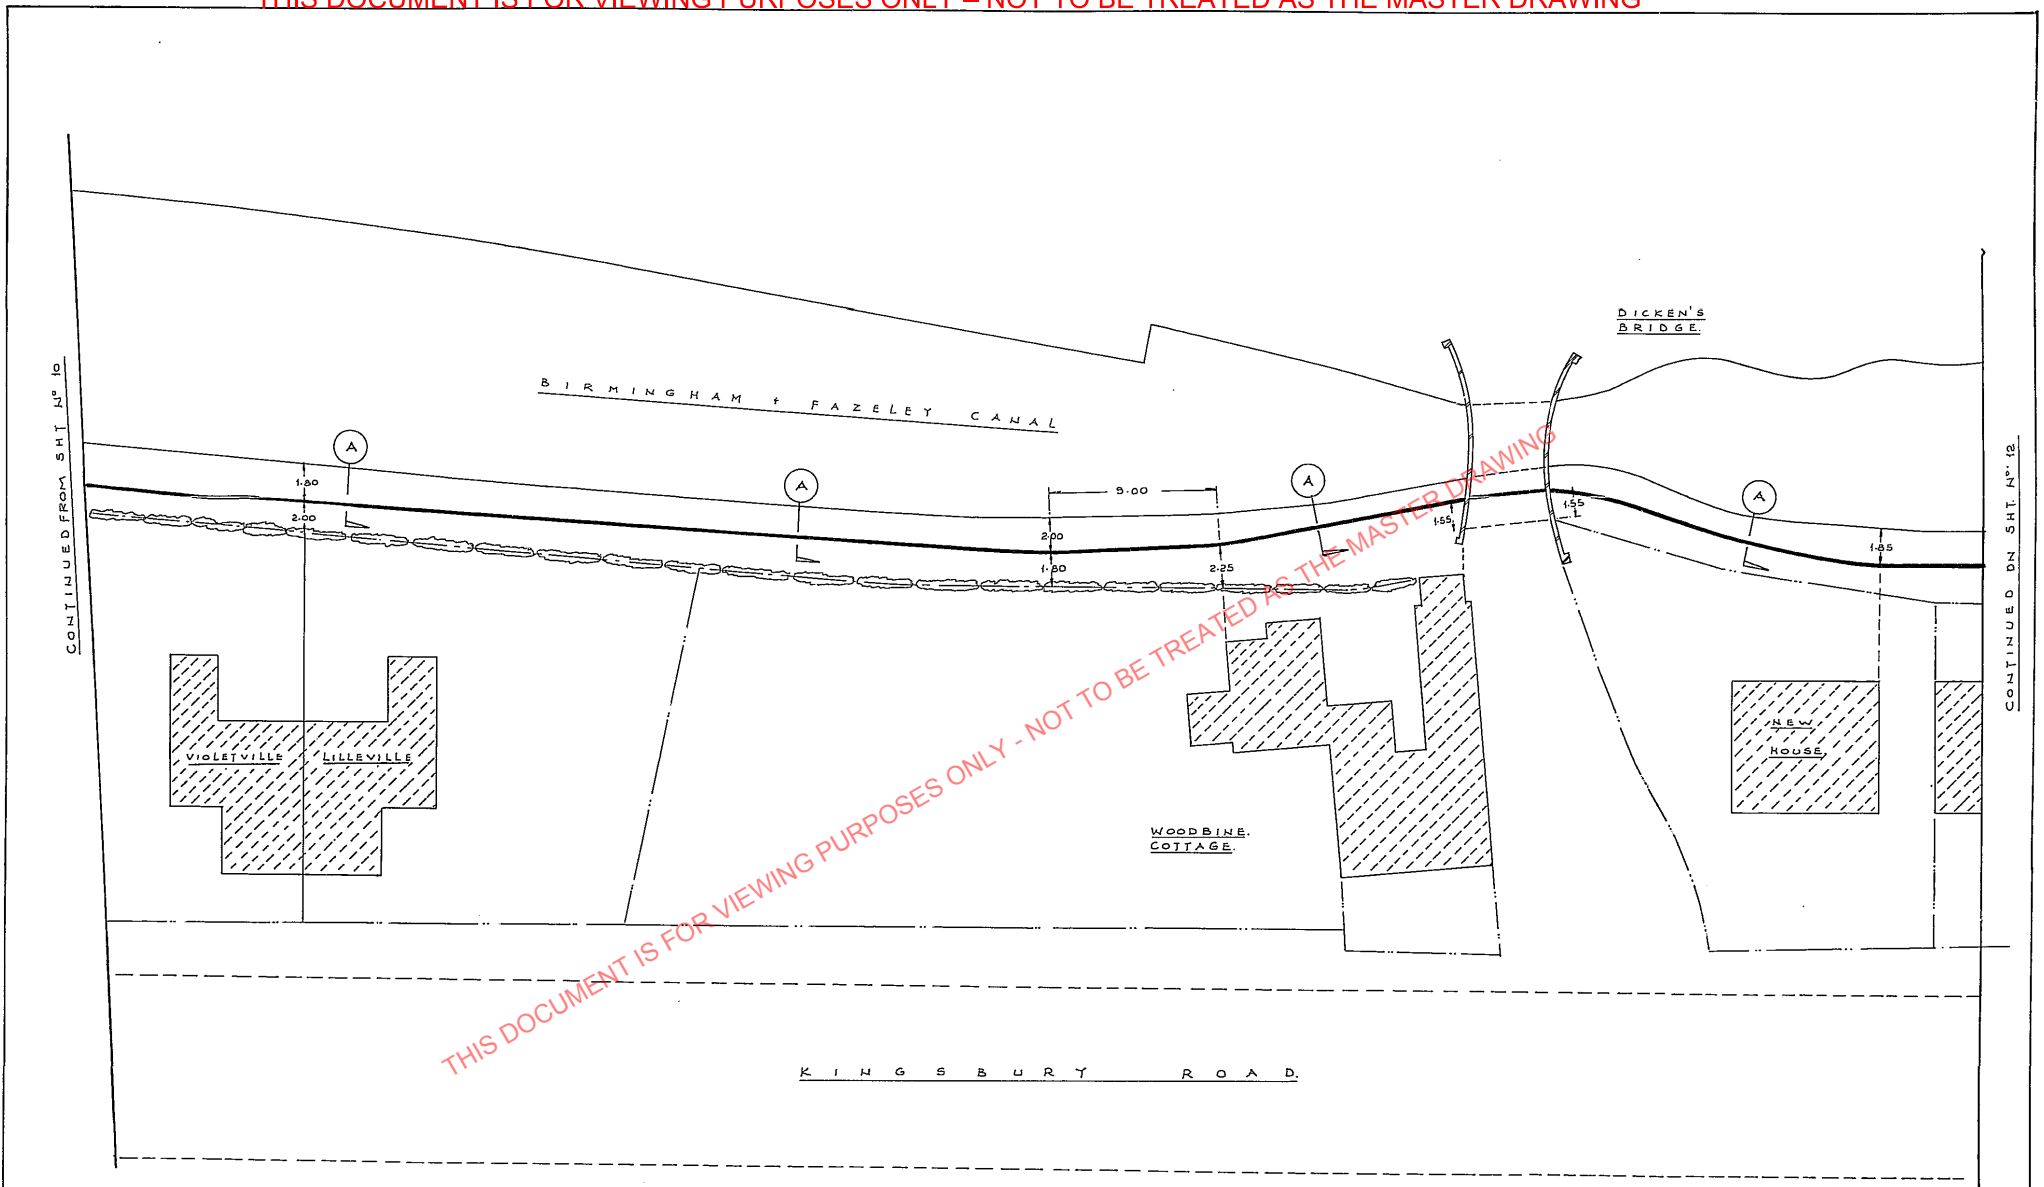


BALFOUR KILPATRICK  
 INSTALLATIONS LTD.  
 DRG. No. M.D. 997

ERDINGTON - HAMS HALL 'PA' PILOTS  
 SECTION 2 : TYBURN - MINWORTH  
 CONTRACT N° 713/RT/EC/1052

SCALE: 1:200 M.	
CENTRAL ELECTRICITY GENERATING BOARD MIDLANDS REGION	
DRG. No. 70D364	
DATE SEPT '73	SHEET No 11. No OF SHEETS: 16

70/16940 skt 11

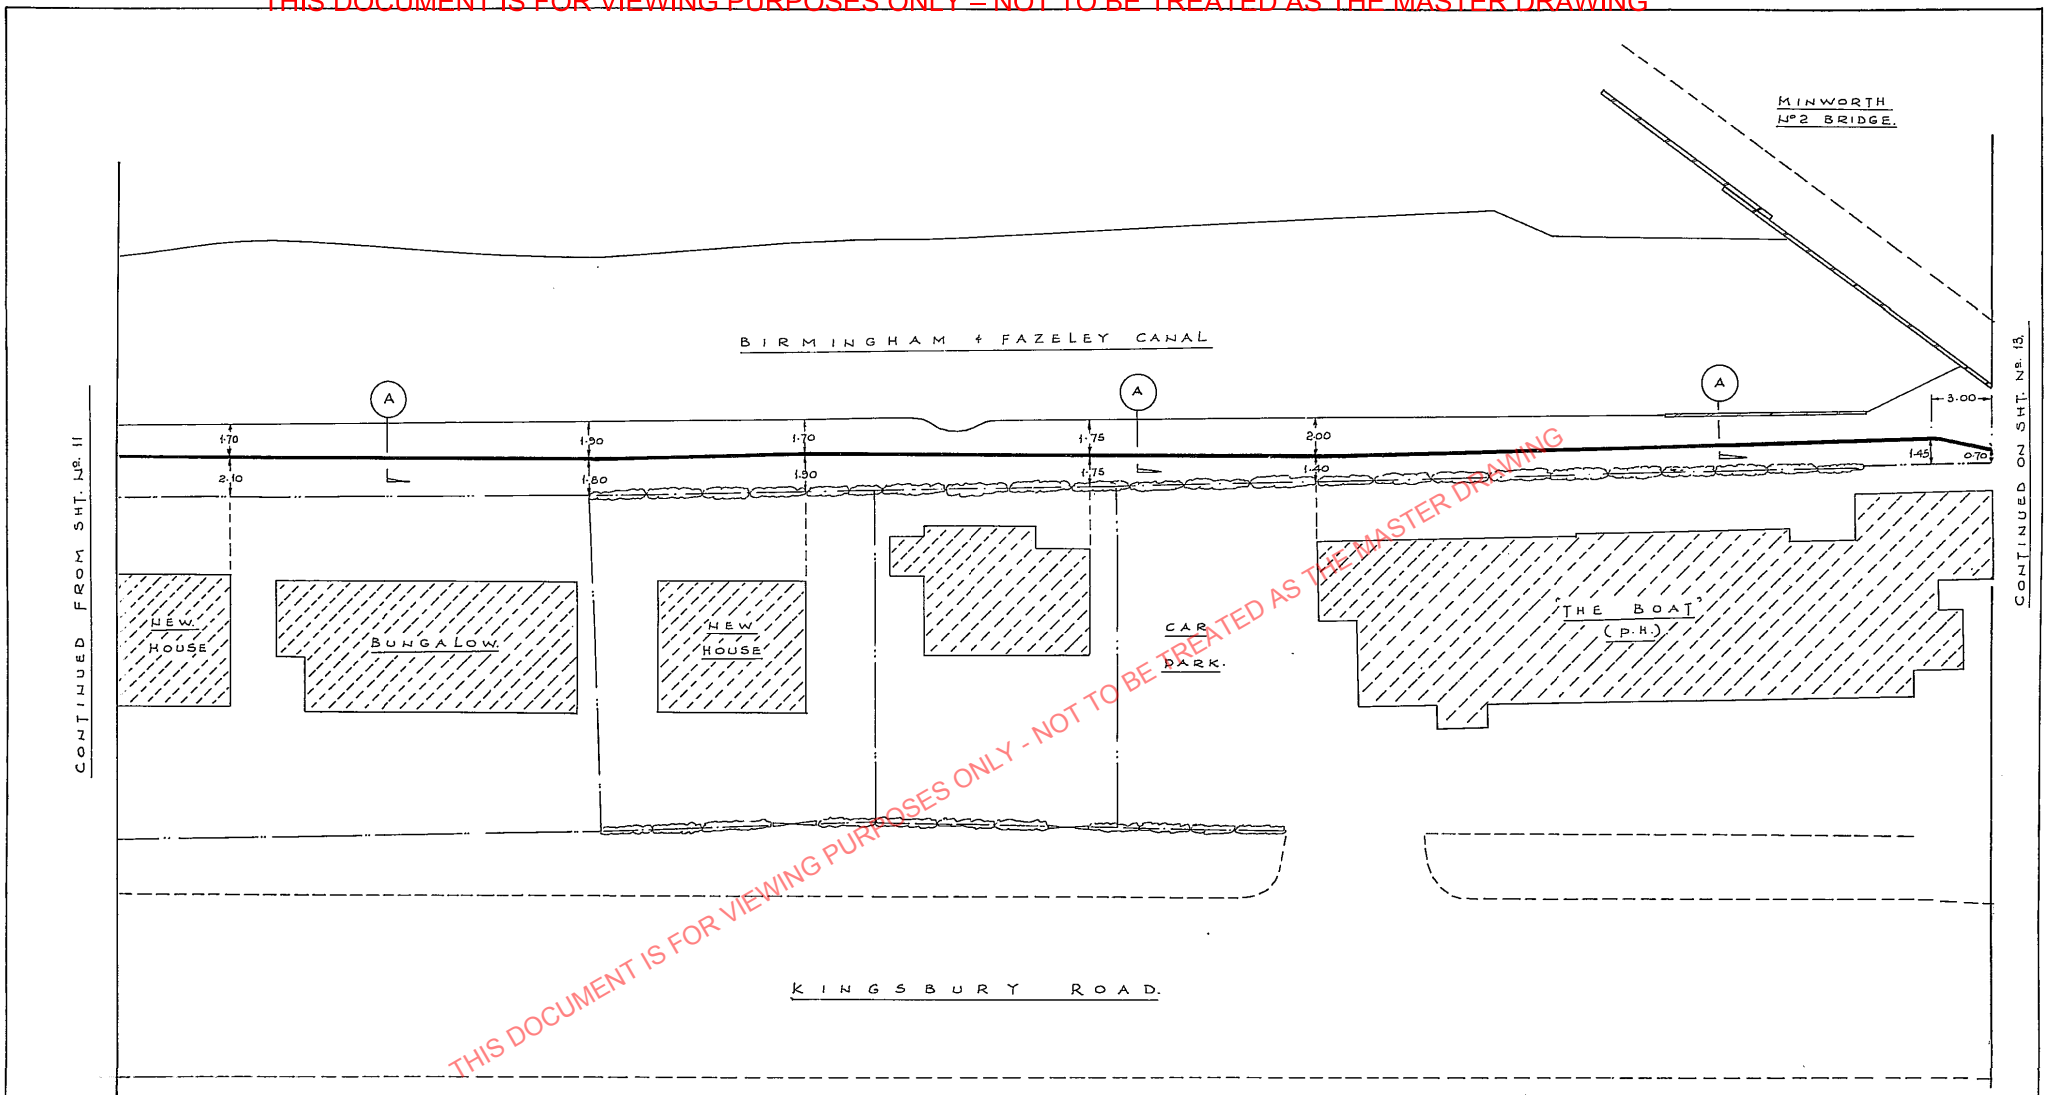

CONTINUED FROM SHT. N° II

CONTINUED ON SHT. N° 13


THIS DOCUMENT IS FOR VIEWING PURPOSES ONLY - NOT TO BE TREATED AS THE MASTER DRAWING

BALFOUR KILPATRICK  
INSTALLATIONS LTD.  
DRG. No. M.D. 997.

ERDINGTON - HAMS HALL 'PA' PILOTS  
SECTION 2: TYBURN - MINWORTH  
CONTRACT N° 713/RT/EC/1052

SCALE:- 1:200 M	
CENTRAL ELECTRICITY GENERATING BOARD MIDLANDS REGION	
DRG. No. 70D364	
DATE SEPT '73	SHEET No 12. No OF SHEETS:- 16

70/16940 sht 12

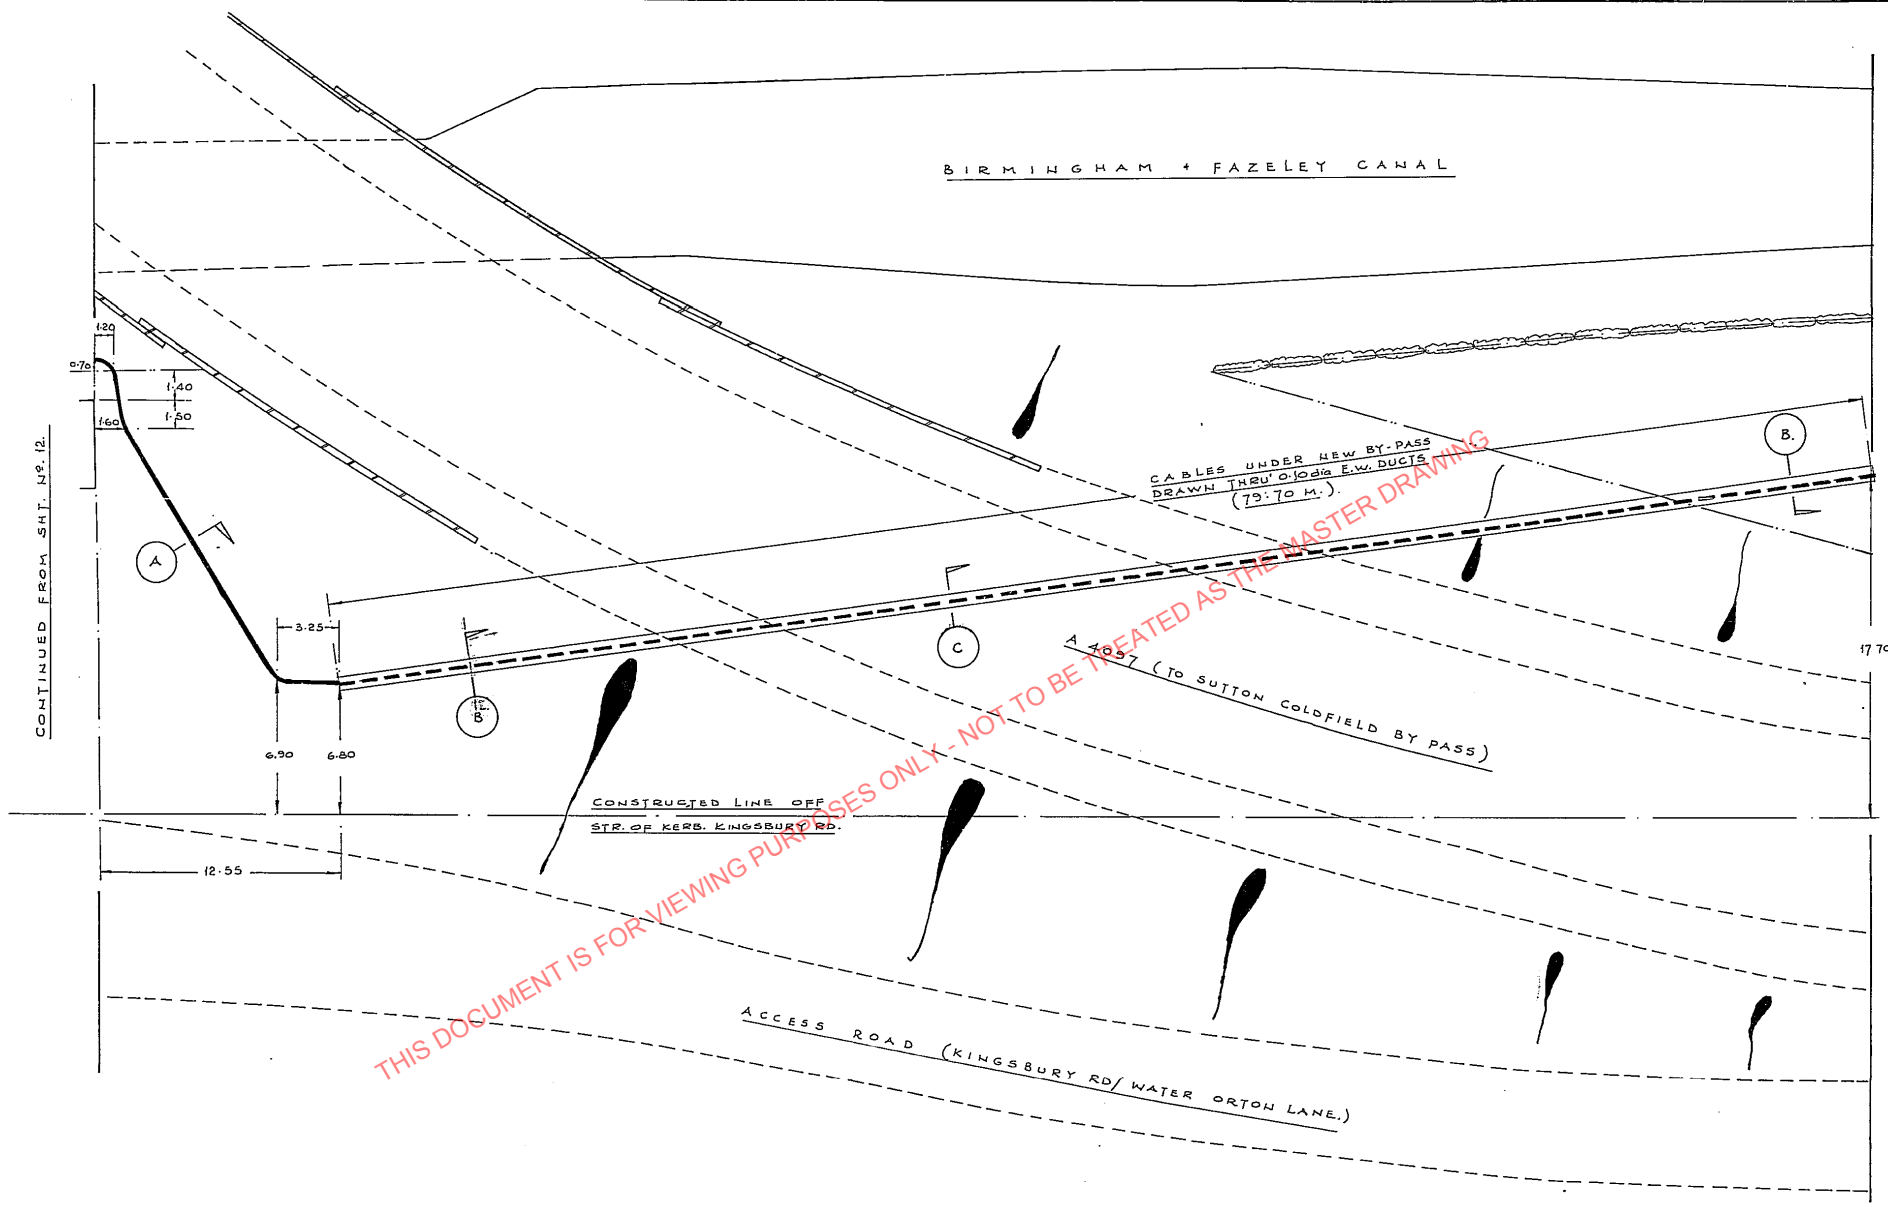

CONTINUED FROM SHT. N<sup>o</sup>. 12.


CONTINUED ON SHT. N<sup>o</sup>. 14.

BALFOUR KILPATRICK  
INSTALLATIONS LTD.  
DRG. No. M.D. 997

ERDINGTON - HAMS HALL 'PA' PILOTS  
SECTION 2: TYBURN - MINWORTH  
CONTRACT N<sup>o</sup> 713/RT/EC/1052

SCALE:- 1:200 M.	
CENTRAL ELECTRICITY GENERATING BOARD MIDLANDS REGION.	
DRG. No. 70D364	
DATE SEPT '73	SHEET No 13. No OF SHEETS: 16

70/16040 skt 13



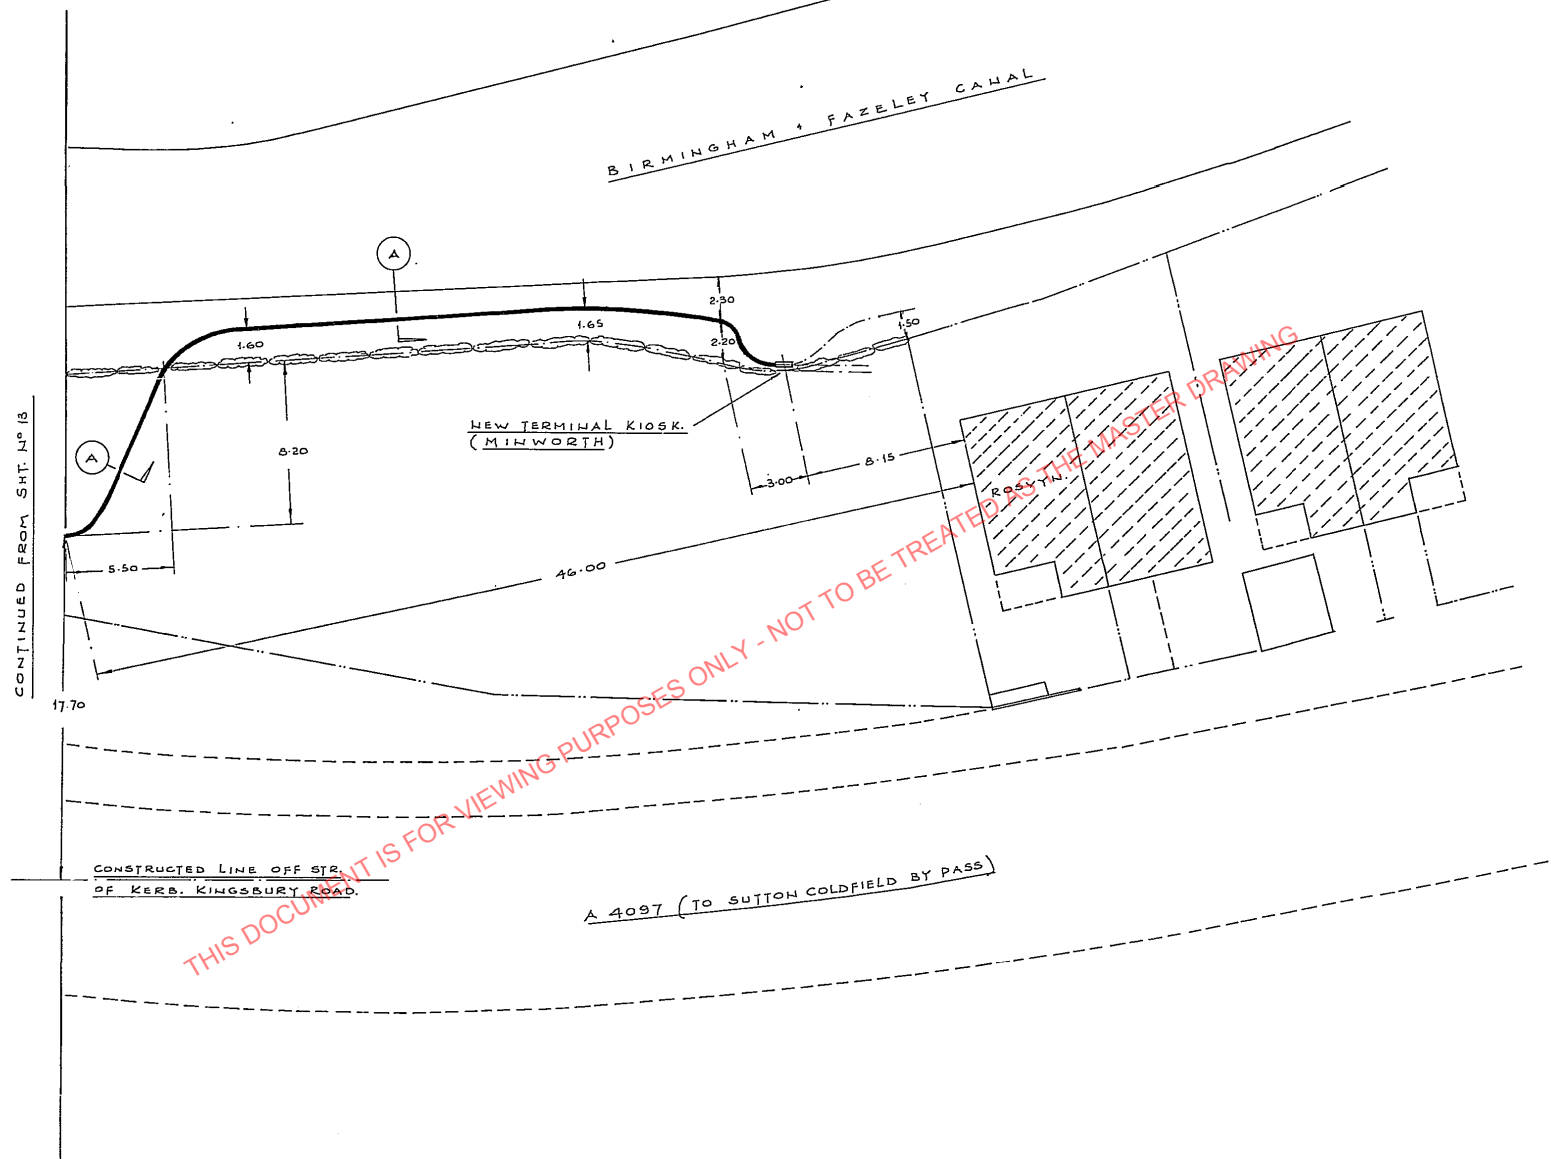


BALFOUR KILPATRICK  
INSTALLATIONS LTD.  
DRG.No. M.D. 997

ERDINGTON – HAMS HALL 'PA' PILOTS  
SECTION 2 : TYBURN – MINWORTH  
CONTRACT N°713/RT/EC/1052

SCALE: 1:200 M.	
CENTRAL ELECTRICITY GENERATING BOARD MIDLANDS REGION	
DRG. No. 70D364.	
DATE SEPT '73	SHEET No 14. No OF SHEETS: 16

70/16940 sht 14

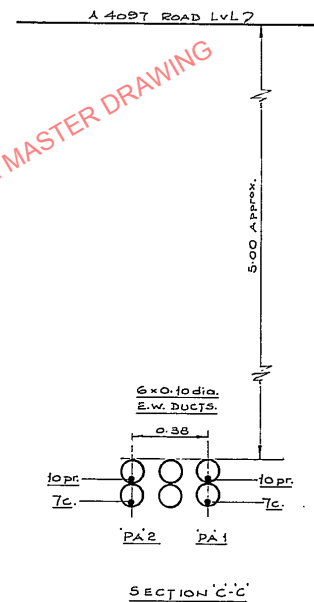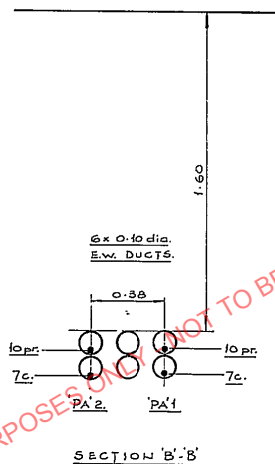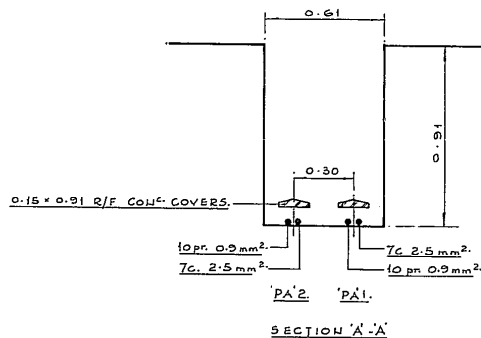

THIS DOCUMENT IS FOR VIEWING PURPOSES ONLY – NOT TO BE TREATED AS THE MASTER DRAWING

SECTIONS FACING MINWORTH.

BALFOUR KILPATRICK  
INSTALLATIONS LTD.

DRG. No. M.D. 997.

ERDINGTON – HAMS HALL 'PA' PILOTS  
SECTION 2: TYBURN – MINWORTH  
CONTRACT N° 713/RT/EC/1052

SCALE:- 1:20 M.

CENTRAL ELECTRICITY GENERATING BOARD  
MIDLANDS REGION

DRG. No. 70D364

DATE SHEET No 15.  
SEPT '73 No OF SHEETS: 16

70/16940 skt 15



## Openreach Plant Maps Requested

NewSite Office (addresses can be located from [here](#))  
National Freephone: 0800 616 866

**Dear Sir/Madam,**

Thank you for your request to: [www.openreach.co.uk/networkinfo/](http://www.openreach.co.uk/networkinfo/)

You have downloaded copies of our drawings marked up to show the approximate location of Openreach apparatus, which is present in the immediate vicinity of your works. It is intended for general guidance only. No guarantee is given of its accuracy. It should not be relied upon in the event of excavations or other works made near to Openreach apparatus, which may, exist at various depths and may deviate, from the marked route.

To avoid damage it is recommended that mechanical excavators or borers are not used within 600mm of Openreach plant. Please ensure that our equipment is not enclosed, blocked, covered or otherwise obstructed by your plant. In the event of clearance not being adequate we anticipate that your plant is either resited, or an order is placed with Openreach for rearrangements of its plant. If there are any difficulties with the Map please ring 0800 616866.

---

Please contact our Network Protection Service if required by dialling 0800 917 3993 or by Email on [DBYD@openreach.co.uk](mailto:DBYD@openreach.co.uk) giving seven days notice of your commencement date. This will provide you with on-site advice and a check of location for any Openreach apparatus.

---

Further to this, I hope the following points will assist you at the new development: -

Openreach has a licence obligation to provide service to any end customer requiring a connection. A Developer would not normally be charged for provision of service, our standard connection charges would apply to the end user when orders are placed with the communication provider of choice. However, should a Developer insist on an underground service in an area where Openreach plant is provided overhead, charges may be incurred.

When the Developer has obtained contract and planning permission Openreach would request a 'Clean', scaled Site Layout, Location Map and a covering letter be sent to the relevant newSite Office. We would particularly request that you give details of your programmed site start date and likely first occupancy date where possible. To obtain contact details of the newSite office covering the development area click on the URL below.

<http://www.openreach.co.uk/orgp/networkinfo/developnetwork/regionalcontacts.do>

Where a development affects existing Openreach apparatus in the public highway, the cost of any necessary protection or diversionary works must be borne by the Developer. In this case where a budget estimate is required a Site Plan, Location Map and a covering letter should be forwarded to the Repayments Project Office. Please visit <http://www.openreach.co.uk/orgp/networkinfo/alternetwork/alterationcontacts.do> for contact details of the Repayments Office covering the development area.

Yours faithfully,

## Openreach newSites

# Maps by email Plant Information Reply



## IMPORTANT WARNING

Information regarding the location of BT apparatus is given for your assistance and is intended for general guidance only. No guarantee is given of its accuracy.

It should not be relied upon in the event of excavations or other works being made near to BT apparatus which may exist at various depths and may deviate from the marked route.

## DIAL BEFORE YOU DIG

FOR PROFESSIONAL ON SITE ASSISTANCE PRIOR TO COMMENCEMENT OF EXCAVATION WORKS

ADVANCE NOTICE REQUIRED  
(Office hours: Monday-Friday 08.00 to 17.00)

Tel: 0800 9173993  
E-mail: [dbyd@openreach.co.uk](mailto:dbyd@openreach.co.uk)  
Website: [www.dialbeforeyoudig.com](http://www.dialbeforeyoudig.com)

Reproduced from the Ordnance Survey map by BT by permission of Ordnance Survey on behalf of the Controller of Her Majesty's Stationary Office  
(C) Crown Copyright British Telecommunications plc 100028040

## KEY TO BT SYMBOLS

	UNDERGROUND PLANT		POLE
	OVERHEAD PLANT		CABINET
	JOINT BOX		BURIED JOINT
	DISTRIBUTION POINT		JOINTING POST
	MANHOLE		PROPOSED U/G
	DP BOUNDARY		PROPOSED O/H
	OTHER BT BOUNDARY		PROPOSED BOX

Other proposed plant is shown using dashed lines. BT symbols not listed above may be disregarded. Existing BT plant may not be recorded. Information valid at the time of preparation.



BT Ref : BAY11167N

Map Reference : (centre) SP1508593601

Easting/Northing : (centre) 415085,293601

Issued : 14/04/2014 11:16:23

**FOOTNOTE: WARNING IT IS ESSENTIAL THAT YOU CONTACT NATIONAL NETWORK HANDLING CENTRE BY EMAIL [nnhc@openreach.co.uk](mailto:nnhc@openreach.co.uk) BEFORE PROCEEDING WITH ANY WORK IN THE HATCHED AREA**

# Maps by email Plant Information Reply



## IMPORTANT WARNING

Information regarding the location of BT apparatus is given for your assistance and is intended for general guidance only. No guarantee is given of its accuracy.

It should not be relied upon in the event of excavations or other works being made near to BT apparatus which may exist at various depths and may deviate from the marked route.

## DIAL BEFORE YOU DIG

FOR PROFESSIONAL ON SITE ASSISTANCE PRIOR TO COMMENCEMENT OF EXCAVATION WORKS

ADVANCE NOTICE REQUIRED  
(Office hours: Monday-Friday 08.00 to 17.00)

Tel: 0800 9173993  
E-mail: [dbyd@openreach.co.uk](mailto:dbyd@openreach.co.uk)  
Website: [www.dialbeforeyoudig.com](http://www.dialbeforeyoudig.com)

Reproduced from the Ordnance Survey map by BT by permission of Ordnance Survey on behalf of the Controller of Her Majesty's Stationary Office  
(C) Crown Copyright British Telecommunications plc 100028040

## KEY TO BT SYMBOLS

	UNDERGROUND PLANT		POLE
	A/C, D/W or W OVERHEAD PLANT		CABINET
	JOINT BOX		BURIED JOINT
	DISTRIBUTION POINT		JOINTING POST
	MANHOLE		PROPOSED U/G
	DP BOUNDARY		A/C, D/W or W PROPOSED O/H
	OTHER BT BOUNDARY		PROPOSED BOX

Other proposed plant is shown using dashed lines. BT symbols not listed above may be disregarded. Existing BT plant may not be recorded. Information valid at the time of preparation.



BT Ref : JUN11157C

Map Reference : (centre) SP1508993136

Easting/Northing : (centre) 415089,293136

Issued : 14/04/2014 11:16:01

**FOOTNOTE: WARNING IT IS ESSENTIAL THAT YOU CONTACT NATIONAL NETWORK HANDLING CENTRE BY EMAIL [nnhc@openreach.co.uk](mailto:nnhc@openreach.co.uk) BEFORE PROCEEDING WITH ANY WORK IN THE HATCHED AREA**



# Maps by email Plant Information Reply



## IMPORTANT WARNING

Information regarding the location of BT apparatus is given for your assistance and is intended for general guidance only. No guarantee is given of its accuracy.

It should not be relied upon in the event of excavations or other works being made near to BT apparatus which may exist at various depths and may deviate from the marked route.

## DIAL BEFORE YOU DIG

FOR PROFESSIONAL ON SITE ASSISTANCE PRIOR TO COMMENCEMENT OF EXCAVATION WORKS

ADVANCE NOTICE REQUIRED  
(Office hours: Monday-Friday 08.00 to 17.00)

Tel: 0800 9173993  
E-mail: [dbyd@openreach.co.uk](mailto:dbyd@openreach.co.uk)  
Website: [www.dialbeforeyoudig.com](http://www.dialbeforeyoudig.com)

Reproduced from the Ordnance Survey map by BT by permission of Ordnance Survey on behalf of the Controller of Her Majesty's Stationary Office  
(C) Crown Copyright British Telecommunications plc 100028040

## KEY TO BT SYMBOLS

	UNDERGROUND PLANT		POLE
	OVERHEAD PLANT		CABINET
	JOINT BOX		BURIED JOINT
	DISTRIBUTION POINT		JOINTING POST
	MANHOLE		PROPOSED U/G
	DP BOUNDARY		PROPOSED O/H
	OTHER BT BOUNDARY		PROPOSED BOX

Other proposed plant is shown using dashed lines. BT symbols not listed above may be disregarded. Existing BT plant may not be recorded. Information valid at the time of preparation.



BT Ref : HDF11159U

Map Reference : (centre) SP1554093140

Easting/Northing : (centre) 415540,293140

Issued : 14/04/2014 11:15:48

**FOOTNOTE: WARNING IT IS ESSENTIAL THAT YOU CONTACT NATIONAL NETWORK HANDLING CENTRE BY EMAIL [nnhc@openreach.co.uk](mailto:nnhc@openreach.co.uk) BEFORE PROCEEDING WITH ANY WORK IN THE HATCHED AREA**

# Maps by email Plant Information Reply



## IMPORTANT WARNING

Information regarding the location of BT apparatus is given for your assistance and is intended for general guidance only. No guarantee is given of its accuracy.

It should not be relied upon in the event of excavations or other works being made near to BT apparatus which may exist at various depths and may deviate from the marked route.

## DIAL BEFORE YOU DIG

FOR PROFESSIONAL ON SITE ASSISTANCE PRIOR TO COMMENCEMENT OF EXCAVATION WORKS

ADVANCE NOTICE REQUIRED  
(Office hours: Monday-Friday 08.00 to 17.00)

Tel: 0800 9173993  
E-mail: [dbyd@openreach.co.uk](mailto:dbyd@openreach.co.uk)  
Website: [www.dialbeforeyoudig.com](http://www.dialbeforeyoudig.com)

Reproduced from the Ordnance Survey map by BT by permission of Ordnance Survey on behalf of the Controller of Her Majesty's Stationary Office  
(C) Crown Copyright British Telecommunications plc 100028040

## KEY TO BT SYMBOLS

	UNDERGROUND PLANT		POLE
	OVERHEAD PLANT		CABINET
	JOINT BOX		BURIED JOINT
	DISTRIBUTION POINT		JOINTING POST
	MANHOLE		PROPOSED U/G
	DP BOUNDARY		PROPOSED O/H
	OTHER BT BOUNDARY		PROPOSED BOX

Other proposed plant is shown using dashed lines. BT symbols not listed above may be disregarded. Existing BT plant may not be recorded. Information valid at the time of preparation.

**openreach**  
a BT Group business

BT Ref : KPW11159Z

Map Reference : (centre) SP1599493142

Easting/Northing : (centre) 415994,293142

Issued : 14/04/2014 11:15:27

**FOOTNOTE: WARNING IT IS ESSENTIAL THAT YOU CONTACT NATIONAL NETWORK HANDLING CENTRE BY EMAIL [nnhc@openreach.co.uk](mailto:nnhc@openreach.co.uk) BEFORE PROCEEDING WITH ANY WORK IN THE HATCHED AREA**

# Maps by email Plant Information Reply



## IMPORTANT WARNING

Information regarding the location of BT apparatus is given for your assistance and is intended for general guidance only. No guarantee is given of its accuracy.

It should not be relied upon in the event of excavations or other works being made near to BT apparatus which may exist at various depths and may deviate from the marked route.

## DIAL BEFORE YOU DIG

FOR PROFESSIONAL ON SITE ASSISTANCE PRIOR TO COMMENCEMENT OF EXCAVATION WORKS

ADVANCE NOTICE REQUIRED  
(Office hours: Monday-Friday 08.00 to 17.00)

Tel: 0800 9173993  
E-mail: [dbyd@openreach.co.uk](mailto:dbyd@openreach.co.uk)  
Website: [www.dialbeforeyoudig.com](http://www.dialbeforeyoudig.com)

Reproduced from the Ordnance Survey map by BT by permission of Ordnance Survey on behalf of the Controller of Her Majesty's Stationary Office  
(C) Crown Copyright British Telecommunications plc 100028040

## KEY TO BT SYMBOLS

	UNDERGROUND PLANT		POLE
	OVERHEAD PLANT		CABINET
	JOINT BOX		BURIED JOINT
	DISTRIBUTION POINT		JOINTING POST
	MANHOLE		PROPOSED U/G
	DP BOUNDARY		PROPOSED O/H
	OTHER BT BOUNDARY		PROPOSED BOX

Other proposed plant is shown using dashed lines. BT symbols not listed above may be disregarded. Existing BT plant may not be recorded. Information valid at the time of preparation.



BT Ref : KDF11155U

Map Reference : (centre) SP1644792685

Easting/Northing : (centre) 416447,292685

Issued : 14/04/2014 11:15:13

**FOOTNOTE: WARNING IT IS ESSENTIAL THAT YOU CONTACT NATIONAL NETWORK HANDLING CENTRE BY EMAIL [nnhc@openreach.co.uk](mailto:nnhc@openreach.co.uk) BEFORE PROCEEDING WITH ANY WORK IN THE HATCHED AREA**

# Maps by email Plant Information Reply



## IMPORTANT WARNING

Information regarding the location of BT apparatus is given for your assistance and is intended for general guidance only. No guarantee is given of its accuracy.

It should not be relied upon in the event of excavations or other works being made near to BT apparatus which may exist at various depths and may deviate from the marked route.

## DIAL BEFORE YOU DIG

FOR PROFESSIONAL ON SITE ASSISTANCE PRIOR TO COMMENCEMENT OF EXCAVATION WORKS

ADVANCE NOTICE REQUIRED  
(Office hours: Monday-Friday 08.00 to 17.00)

Tel: 0800 9173993  
E-mail: [dbyd@openreach.co.uk](mailto:dbyd@openreach.co.uk)  
Website: [www.dialbeforeyoudig.com](http://www.dialbeforeyoudig.com)

Reproduced from the Ordnance Survey map by BT by permission of Ordnance Survey on behalf of the Controller of Her Majesty's Stationary Office  
(C) Crown Copyright British Telecommunications plc 100028040

## KEY TO BT SYMBOLS

	UNDERGROUND PLANT		POLE
	OVERHEAD PLANT		CABINET
	JOINT BOX		BURIED JOINT
	DISTRIBUTION POINT		JOINTING POST
	MANHOLE		PROPOSED U/G
	DP BOUNDARY		PROPOSED O/H
	OTHER BT BOUNDARY		PROPOSED BOX

Other proposed plant is shown using dashed lines. BT symbols not listed above may be disregarded. Existing BT plant may not be recorded. Information valid at the time of preparation.



BT Ref : QNR11148Z

Map Reference : (centre) SP1599692680

Easting/Northing : (centre) 415996,292680

Issued : 14/04/2014 11:14:52

**FOOTNOTE: WARNING IT IS ESSENTIAL THAT YOU CONTACT NATIONAL NETWORK HANDLING CENTRE BY EMAIL [nnhc@openreach.co.uk](mailto:nnhc@openreach.co.uk) BEFORE PROCEEDING WITH ANY WORK IN THE HATCHED AREA**

# Maps by email Plant Information Reply



## IMPORTANT WARNING

Information regarding the location of BT apparatus is given for your assistance and is intended for general guidance only. No guarantee is given of its accuracy.

It should not be relied upon in the event of excavations or other works being made near to BT apparatus which may exist at various depths and may deviate from the marked route.

## DIAL BEFORE YOU DIG

FOR PROFESSIONAL ON SITE ASSISTANCE PRIOR TO COMMENCEMENT OF EXCAVATION WORKS

ADVANCE NOTICE REQUIRED  
(Office hours: Monday-Friday 08.00 to 17.00)

Tel: 0800 9173993  
E-mail: [dbyd@openreach.co.uk](mailto:dbyd@openreach.co.uk)  
Website: [www.dialbeforeyoudig.com](http://www.dialbeforeyoudig.com)

Reproduced from the Ordnance Survey map by BT by permission of Ordnance Survey on behalf of the Controller of Her Majesty's Stationary Office  
(C) Crown Copyright British Telecommunications plc 100028040

## KEY TO BT SYMBOLS

	UNDERGROUND PLANT		POLE
	OVERHEAD PLANT		CABINET
	JOINT BOX		BURIED JOINT
	DISTRIBUTION POINT		JOINTING POST
	MANHOLE		PROPOSED U/G
	DP BOUNDARY		PROPOSED O/H
	OTHER BT BOUNDARY		PROPOSED BOX

Other proposed plant is shown using dashed lines. BT symbols not listed above may be disregarded. Existing BT plant may not be recorded. Information valid at the time of preparation.

**openreach**  
a BT Group business

BT Ref : MSD11:42P

Map Reference : (centre) SP1554592676

Easting/Northing : (centre) 415545,292676

Issued : 14/04/2014 11:14:41

**FOOTNOTE: WARNING IT IS ESSENTIAL THAT YOU CONTACT NATIONAL NETWORK HANDLING CENTRE BY EMAIL [nnhc@openreach.co.uk](mailto:nnhc@openreach.co.uk) BEFORE PROCEEDING WITH ANY WORK IN THE HATCHED AREA**

# Maps by email Plant Information Reply



## IMPORTANT WARNING

Information regarding the location of BT apparatus is given for your assistance and is intended for general guidance only. No guarantee is given of its accuracy. It should not be relied upon in the event of excavations or other works being made near to BT apparatus which may exist at various depths and may deviate from the marked route.

## DIAL BEFORE YOU DIG

FOR PROFESSIONAL ON SITE ASSISTANCE PRIOR TO COMMENCEMENT OF EXCAVATION WORKS

ADVANCE NOTICE REQUIRED  
(Office hours: Monday-Friday 08.00 to 17.00)

Tel: 0800 9173993  
E-mail: [dbyd@openreach.co.uk](mailto:dbyd@openreach.co.uk)  
Website: [www.dialbeforeyoudig.com](http://www.dialbeforeyoudig.com)

Reproduced from the Ordnance Survey map by BT by permission of Ordnance Survey on behalf of the Controller of Her Majesty's Stationary Office  
(C) Crown Copyright British Telecommunications plc 100028040

## KEY TO BT SYMBOLS

	UNDERGROUND PLANT		POLE
	OVERHEAD PLANT		CABINET
	JOINT BOX		BURIED JOINT
	DISTRIBUTION POINT		JOINTING POST
	MANHOLE		PROPOSED U/G
	DP BOUNDARY		PROPOSED O/H
	OTHER BT BOUNDARY		PROPOSED BOX

Other proposed plant is shown using dashed lines. BT symbols not listed above may be disregarded. Existing BT plant may not be recorded. Information valid at the time of preparation.

**openreach**  
a BT Group business

BT Ref : XVP11144Q


Map Reference : (centre) SP1509192674

Easting/Northing : (centre) 415091,292674

Issued : 14/04/2014 11:14:29

**FOOTNOTE: WARNING IT IS ESSENTIAL THAT YOU CONTACT NATIONAL NETWORK HANDLING CENTRE BY EMAIL [nnhc@openreach.co.uk](mailto:nnhc@openreach.co.uk) BEFORE PROCEEDING WITH ANY WORK IN THE HATCHED AREA**

# Maps by email Plant Information Reply

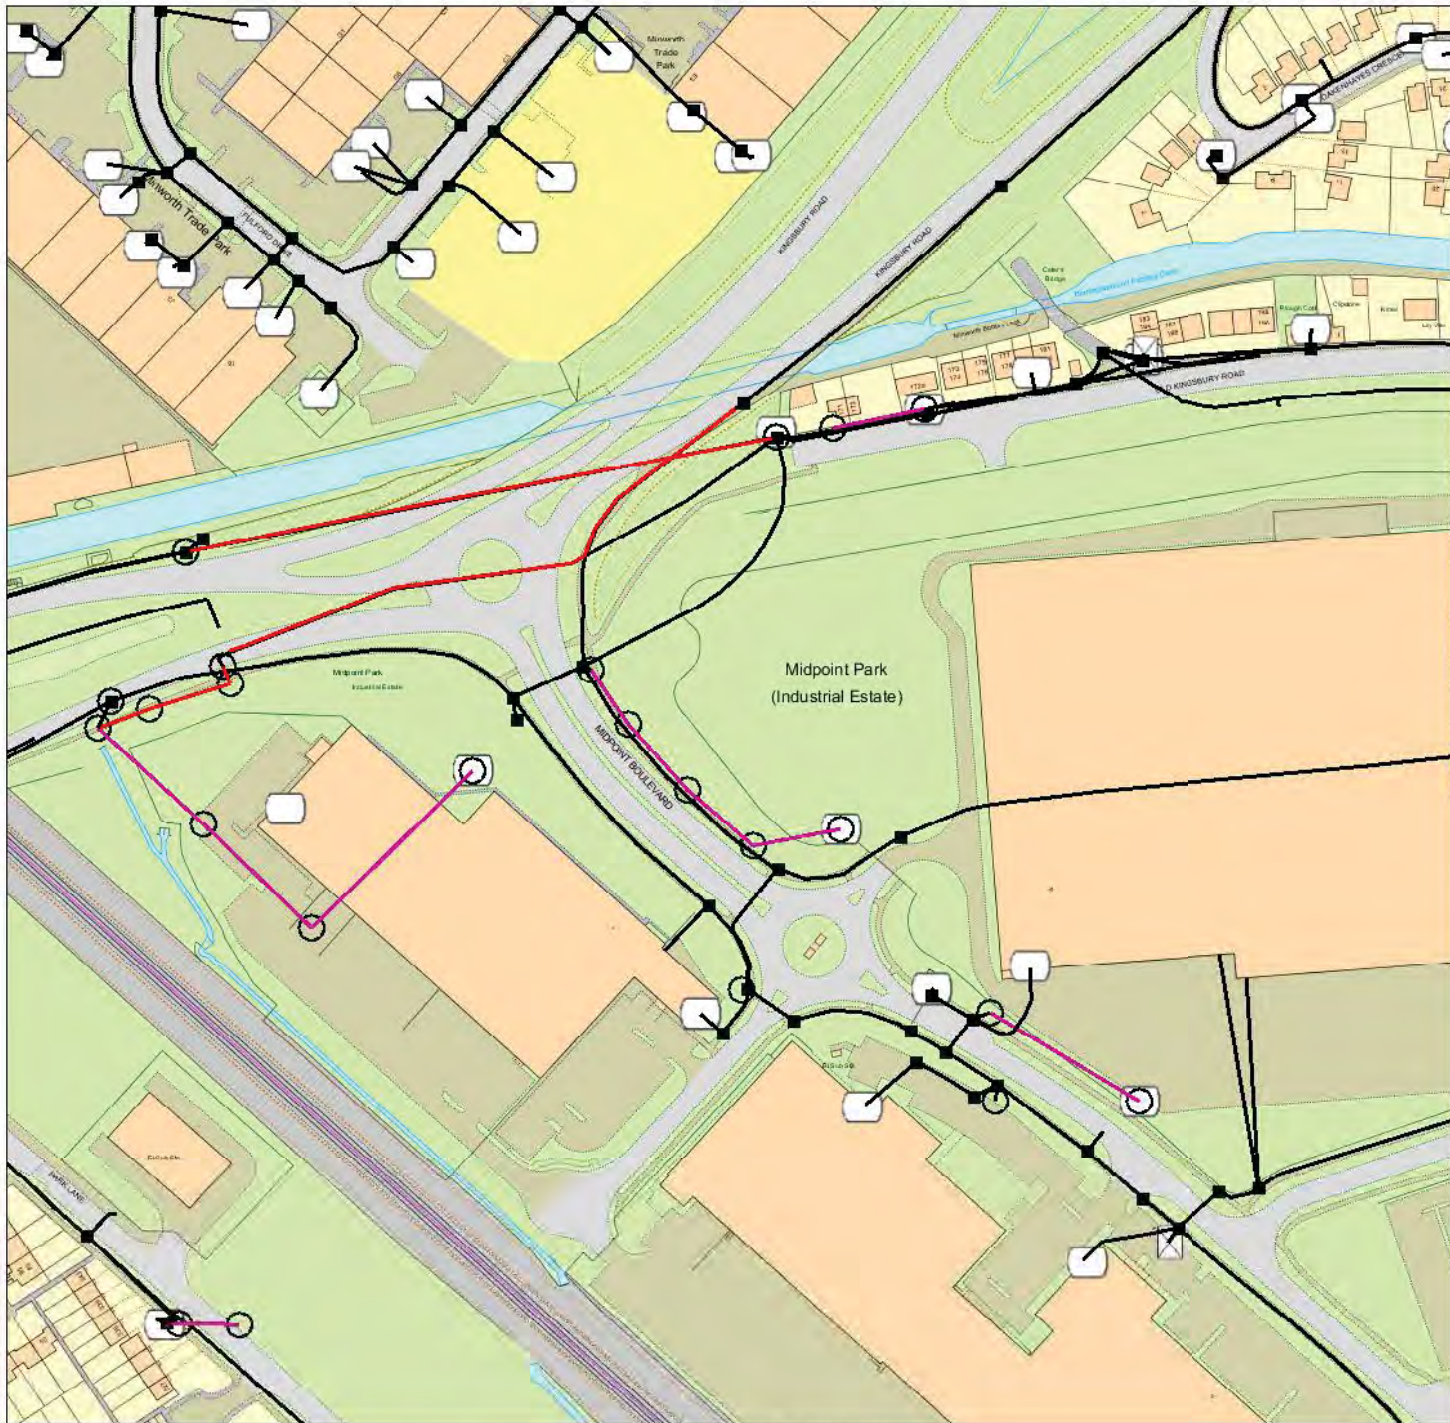

## IMPORTANT WARNING

Information regarding the location of BT apparatus is given for your assistance and is intended for general guidance only. No guarantee is given of its accuracy.

It should not be relied upon in the event of excavations or other works being made near to BT apparatus which may exist at various depths and may deviate from the marked route.

## DIAL BEFORE YOU DIG

FOR PROFESSIONAL ON SITE ASSISTANCE PRIOR TO COMMENCEMENT OF EXCAVATION WORKS

ADVANCE NOTICE REQUIRED  
(Office hours: Monday-Friday 08.00 to 17.00)

Tel: 0800 9173993  
E-mail: [dbyd@openreach.co.uk](mailto:dbyd@openreach.co.uk)  
Website: [www.dialbeforeyoudig.com](http://www.dialbeforeyoudig.com)

Reproduced from the Ordnance Survey map by BT by permission of Ordnance Survey on behalf of the Controller of Her Majesty's Stationary Office  
(C) Crown Copyright British Telecommunications plc 100028040

## KEY TO BT SYMBOLS

	UNDERGROUND PLANT		POLE
	OVERHEAD PLANT		CABINET
	JOINT BOX		BURIED JOINT
	DISTRIBUTION POINT		JOINTING POST
	MANHOLE		PROPOSED U/G
	DP BOUNDARY		PROPOSED O/H
	OTHER BT BOUNDARY		PROPOSED BOX

Other proposed plant is shown using dashed lines. BT symbols not listed above may be disregarded. Existing BT plant may not be recorded. Information valid at the time of preparation.



BT Ref : WNJ111311


Map Reference : (centre) SP1509892213

Easting/Northing : (centre) 415098,292213

Issued : 14/04/2014 11:14:15

**FOOTNOTE: WARNING IT IS ESSENTIAL THAT YOU CONTACT NATIONAL NETWORK HANDLING CENTRE BY EMAIL [nnhc@openreach.co.uk](mailto:nnhc@openreach.co.uk) BEFORE PROCEEDING WITH ANY WORK IN THE HATCHED AREA**

# Maps by email Plant Information Reply

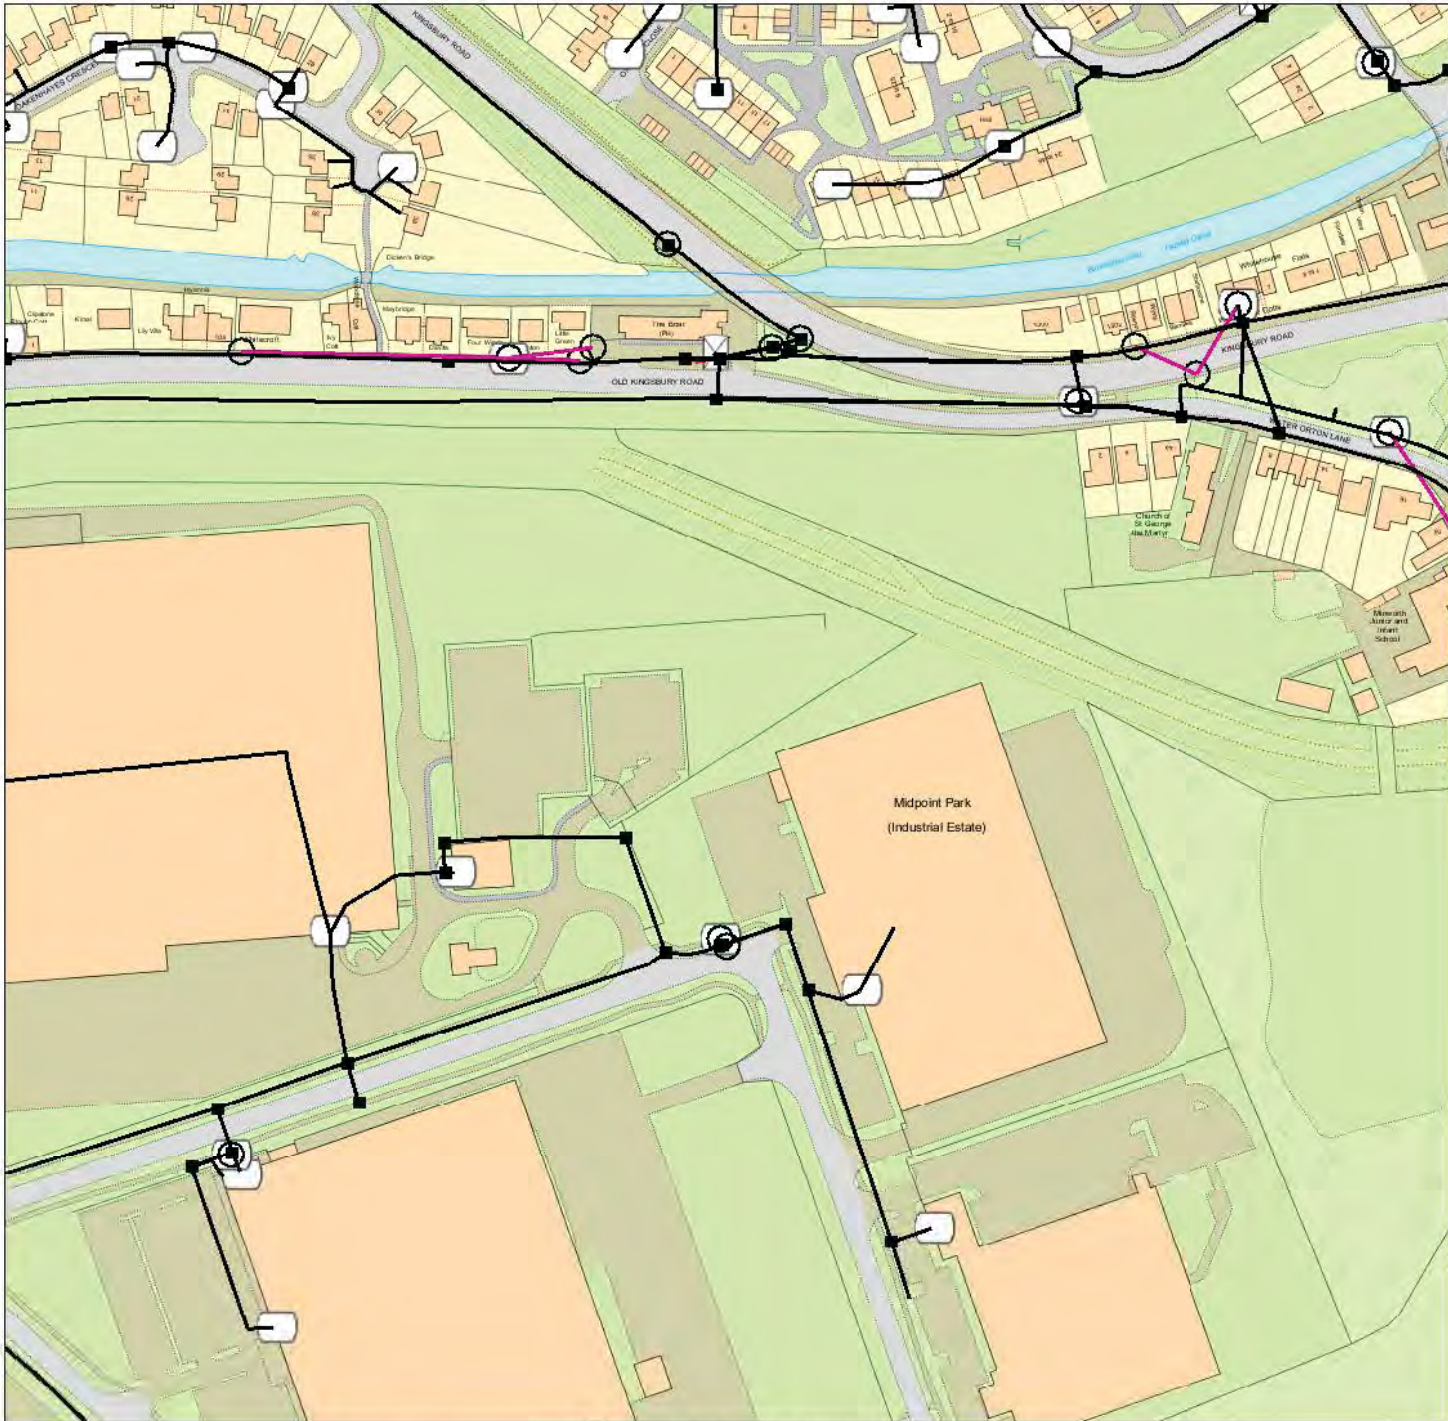

## IMPORTANT WARNING

Information regarding the location of BT apparatus is given for your assistance and is intended for general guidance only. No guarantee is given of its accuracy.

It should not be relied upon in the event of excavations or other works being made near to BT apparatus which may exist at various depths and may deviate from the marked route.

## DIAL BEFORE YOU DIG

FOR PROFESSIONAL ON SITE ASSISTANCE PRIOR TO COMMENCEMENT OF EXCAVATION WORKS

ADVANCE NOTICE REQUIRED  
(Office hours: Monday-Friday 08.00 to 17.00)

Tel: 0800 9173993  
E-mail: [dbyd@openreach.co.uk](mailto:dbyd@openreach.co.uk)  
Website: [www.dialbeforeyoudig.com](http://www.dialbeforeyoudig.com)

Reproduced from the Ordnance Survey map by BT by permission of Ordnance Survey on behalf of the Controller of Her Majesty's Stationary Office  
(C) Crown Copyright British Telecommunications plc 100028040

## KEY TO BT SYMBOLS

	UNDERGROUND PLANT		POLE
	A/C, D/W or W OVERHEAD PLANT		CABINET
	JOINT BOX		BURIED JOINT
	456 OR 456 DISTRIBUTION POINT		JOINTING POST
	72 OR 72 MANHOLE		PROPOSED U/G
	DP BOUNDARY		A/C, D/W or W PROPOSED O/H
	OTHER BT BOUNDARY		PROPOSED BOX

Other proposed plant is shown using dashed lines. BT symbols not listed above may be disregarded. Existing BT plant may not be recorded. Information valid at the time of preparation.

**openreach**  
a BT Group business

BT Ref : PCG11136P

Map Reference : (centre) SP1554992217

Easting/Northing : (centre) 415549,292217

Issued : 14/04/2014 11:13:59

**FOOTNOTE: WARNING IT IS ESSENTIAL THAT YOU CONTACT NATIONAL NETWORK HANDLING CENTRE BY EMAIL [nnhc@openreach.co.uk](mailto:nnhc@openreach.co.uk) BEFORE PROCEEDING WITH ANY WORK IN THE HATCHED AREA**



# Maps by email Plant Information Reply



## IMPORTANT WARNING

Information regarding the location of BT apparatus is given for your assistance and is intended for general guidance only. No guarantee is given of its accuracy. It should not be relied upon in the event of excavations or other works being made near to BT apparatus which may exist at various depths and may deviate from the marked route.

## DIAL BEFORE YOU DIG

**FOR PROFESSIONAL ON SITE ASSISTANCE PRIOR TO COMMENCEMENT OF EXCAVATION WORKS**

ADVANCE NOTICE REQUIRED  
(Office hours: Monday-Friday 08.00 to 17.00)

Tel: 0800 9173993  
E-mail: [dbyd@openreach.co.uk](mailto:dbyd@openreach.co.uk)  
Website: [www.dialbeforeyoudig.com](http://www.dialbeforeyoudig.com)

Reproduced from the Ordnance Survey map by BT by permission of Ordnance Survey on behalf of the Controller of Her Majesty's Stationary Office

(C) Crown Copyright British Telecommunications plc 100028040

## KEY TO BT SYMBOLS

UNDERGROUND PLANT	POLE
OVERHEAD PLANT	CABINET
JOINT BOX	BURIED JOINT
DISTRIBUTION POINT	JOINTING POST
MANHOLE	PROPOSED U/G
DP BOUNDARY	PROPOSED O/H
OTHER BT BOUNDARY	PROPOSED BOX

Other proposed plant is shown using dashed lines. BT symbols not listed above may be disregarded. Existing BT plant may not be recorded. Information valid at the time of preparation.



BT Ref : TUD11134S


Map Reference : (centre) SP1600092218

Easting/Northing : (centre) 416000,292218

Issued : 14/04/2014 11:13:42

**FOOTNOTE: WARNING IT IS ESSENTIAL THAT YOU CONTACT NATIONAL NETWORK HANDLING CENTRE BY EMAIL [nnhc@openreach.co.uk](mailto:nnhc@openreach.co.uk) BEFORE PROCEEDING WITH ANY WORK IN THE HATCHED AREA**

# Maps by email Plant Information Reply

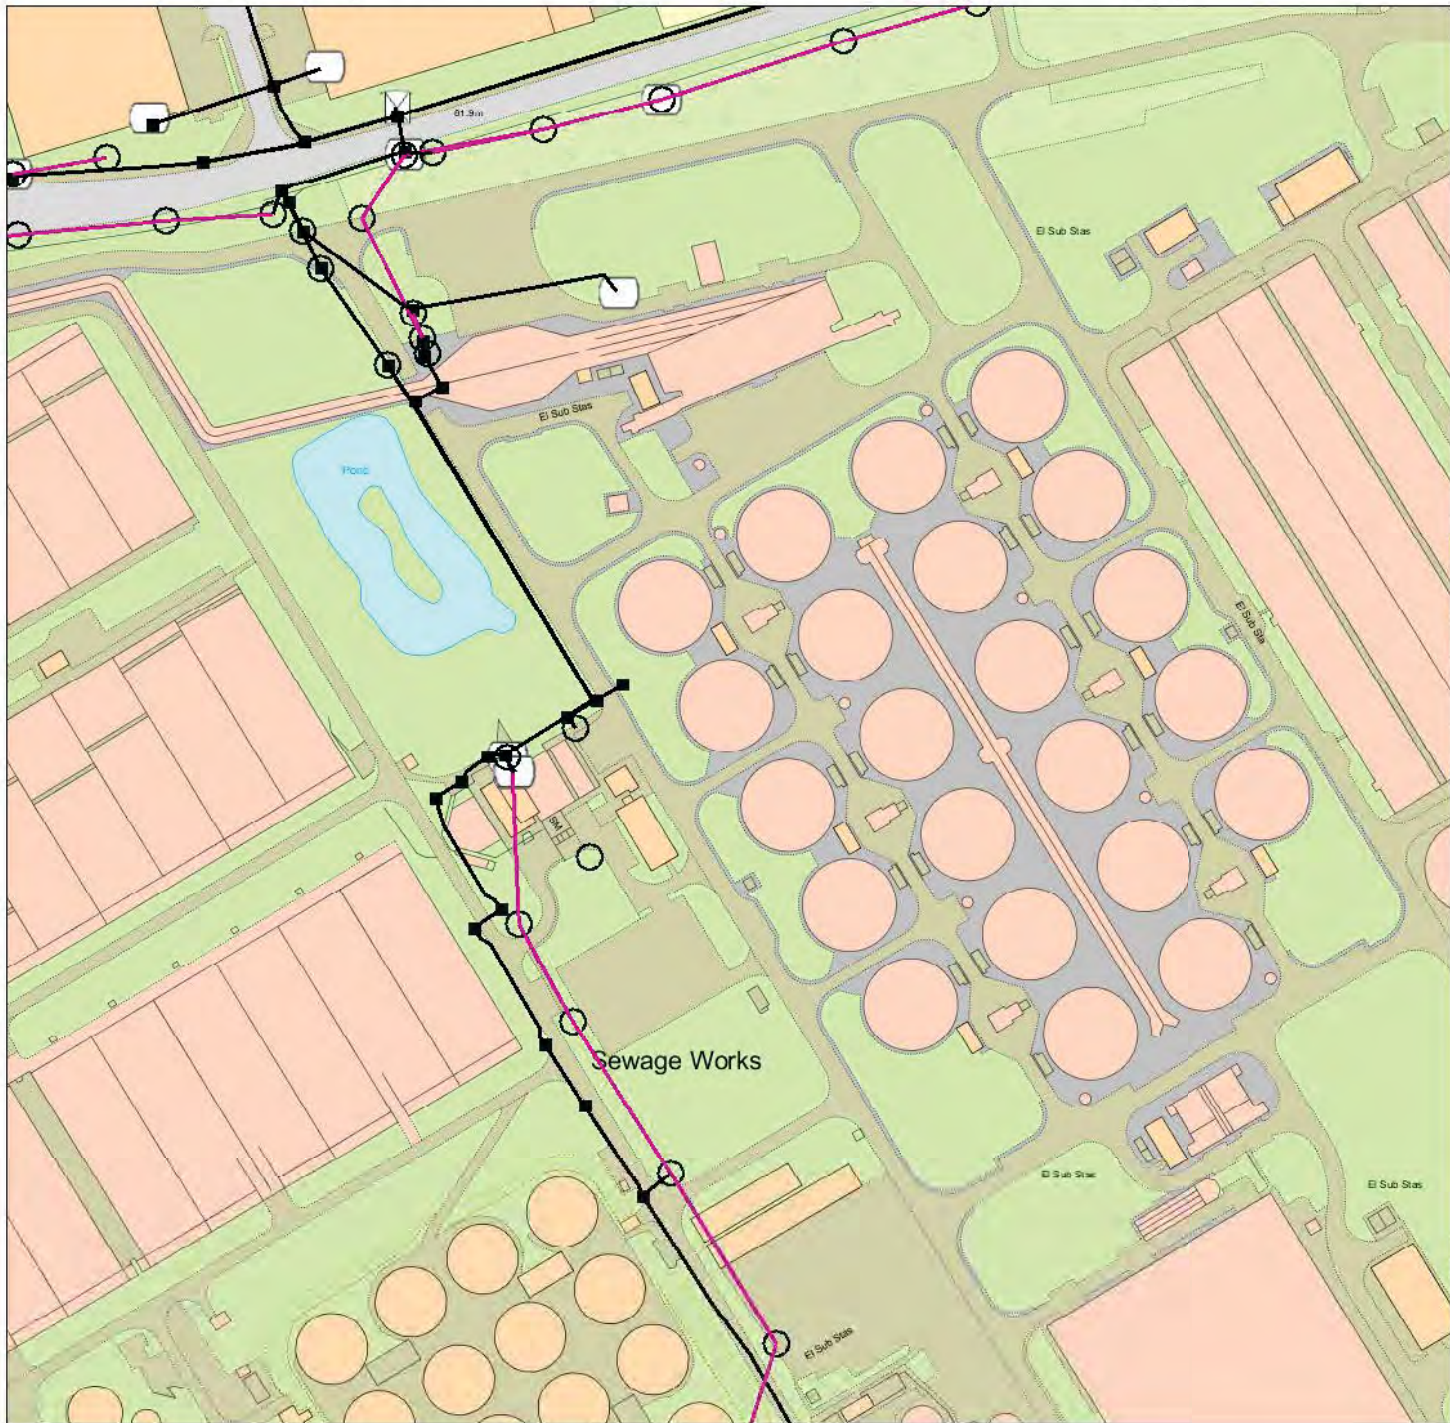

## IMPORTANT WARNING

Information regarding the location of BT apparatus is given for your assistance and is intended for general guidance only. No guarantee is given of its accuracy.

It should not be relied upon in the event of excavations or other works being made near to BT apparatus which may exist at various depths and may deviate from the marked route.

## DIAL BEFORE YOU DIG

FOR PROFESSIONAL ON SITE ASSISTANCE PRIOR TO COMMENCEMENT OF EXCAVATION WORKS

ADVANCE NOTICE REQUIRED  
(Office hours: Monday-Friday 08.00 to 17.00)

Tel: 0800 9173993  
E-mail: [dbyd@openreach.co.uk](mailto:dbyd@openreach.co.uk)  
Website: [www.dialbeforeyoudig.com](http://www.dialbeforeyoudig.com)

Reproduced from the Ordnance Survey map by BT by permission of Ordnance Survey on behalf of the Controller of Her Majesty's Stationary Office  
(C) Crown Copyright British Telecommunications plc 100028040

## KEY TO BT SYMBOLS

	UNDERGROUND PLANT		POLE
	A/C, D/W or W OVERHEAD PLANT		CABINET
	JOINT BOX		BURIED JOINT
	DISTRIBUTION POINT		JOINTING POST
	MANHOLE		PROPOSED U/G
	DP BOUNDARY		A/C, D/W or W PROPOSED O/H
	OTHER BT BOUNDARY		PROPOSED BOX

Other proposed plant is shown using dashed lines. BT symbols not listed above may be disregarded. Existing BT plant may not be recorded. Information valid at the time of preparation.

**openreach**  
a BT Group business

BT Ref : SWO11:39M

Map Reference : (centre) SP1645292217

Easting/Northing : (centre) 416452,292217

Issued : 14/04/2014 11:13:25

**FOOTNOTE: WARNING IT IS ESSENTIAL THAT YOU CONTACT NATIONAL NETWORK HANDLING CENTRE BY EMAIL [nnhc@openreach.co.uk](mailto:nnhc@openreach.co.uk) BEFORE PROCEEDING WITH ANY WORK IN THE HATCHED AREA**

**Our Ref:** MLP//LSBUD-140114-1525462

**Your Ref:** Minworth Rbt Options

**Date:** 18-02-2014

For the attention of Mr Alexander Prosser  
AECOM  
Colmore Plaza  
Colmore Circus Queensway  
Birmingham  
West Midlands  
B4 6AT

FISHER GERMAN LLP  
MAINLINE PIPELINES LIMITED  
PO BOX 9856  
ASHBY DE LA ZOUCH  
LE65 9BZ

**Telephone 0845 4378293**

Email [mainlinepipelines@fishergerman.co.uk](mailto:mainlinepipelines@fishergerman.co.uk)

[www.fishergerman.co.uk](http://www.fishergerman.co.uk)

Dear Sir/Madam

**MAINLINE PIPELINES LIMITED – Seisdon to Kingsbury  
SCHEME: Minworth Rbt Options**

Thank you for your notice dated 14-01-2014 with regard to the above proposed works. We can confirm that it would appear from your plan/s that your works **will affect** our client's apparatus. Prior to any works commencing, you should contact **Mr Richard Broome or Mr Richard Gent on 0845 4378293** so that a site meeting can be arranged to discuss these works in more detail.

**IN ORDER FOR THESE WORKS TO PROCEED SAFELY YOU MUST DO THE FOLLOWING:**

- **ARRANGE SUPERVISION THROUGH THIS OFFICE AT LEAST 48 HOURS IN ADVANCE.**
- **PROVIDE DETAILS OF THE JOB TO BE CARRIED OUT, INCLUDING A METHOD STATEMENT, SITE LOCATION, DETAILED PLANS AND SITE CONTACT INFORMATION IN ADVANCE OF THE WORKS.**

**YOU SHOULD NOTE THAT NO WORKS OF ANY KIND, EITHER BY HAND OR MACHINE, IS PERMITTED WITHIN OUR CLIENT'S 6 METRE "SAFETY ZONE" (3M EITHER SIDE OF THE PIPELINE) WITHOUT PRIOR NOTIFICATION TO OURSELVES TO ENSURE THE INTEGRITY OF OUR CLIENT'S APPARATUS.**

**YOU SHOULD BE AWARE THAT THIS AREA HAS BEEN IDENTIFIED TO US AS HAVING AN ENHANCED RISK OF DISCOVERING UNEXPLODED ORDNANCE. YOU SHOULD TAKE APPROPRIATE MEASURES TO MITIGATE THE RISK.**


We enclose for your information an A3 plan showing the approximate location of our client's apparatus where it crosses your area of concern. In addition please refer to <http://www.linsearch.org/page/Useful-Info> for a copy of our client's "Special Requirements for Safe Working in Close Proximity to High Pressure Oil Pipelines" booklet - a guidelines booklet detailing the sorts of precautions that should be taken when in the vicinity of our client's apparatus – together with a copy of the Marker Post brochure. Hard copies of these documents are available on request.

**THIS RESPONSE AND ANY RELATED INFORMATION MUST BE FORWARDED TO THE PERSON RESPONSIBLE FOR THESE WORKS.**

Yours faithfully

**Mr Richard Broome / Mr Richard Gent  
On behalf of FISHER GERMAN LLP  
Enc**




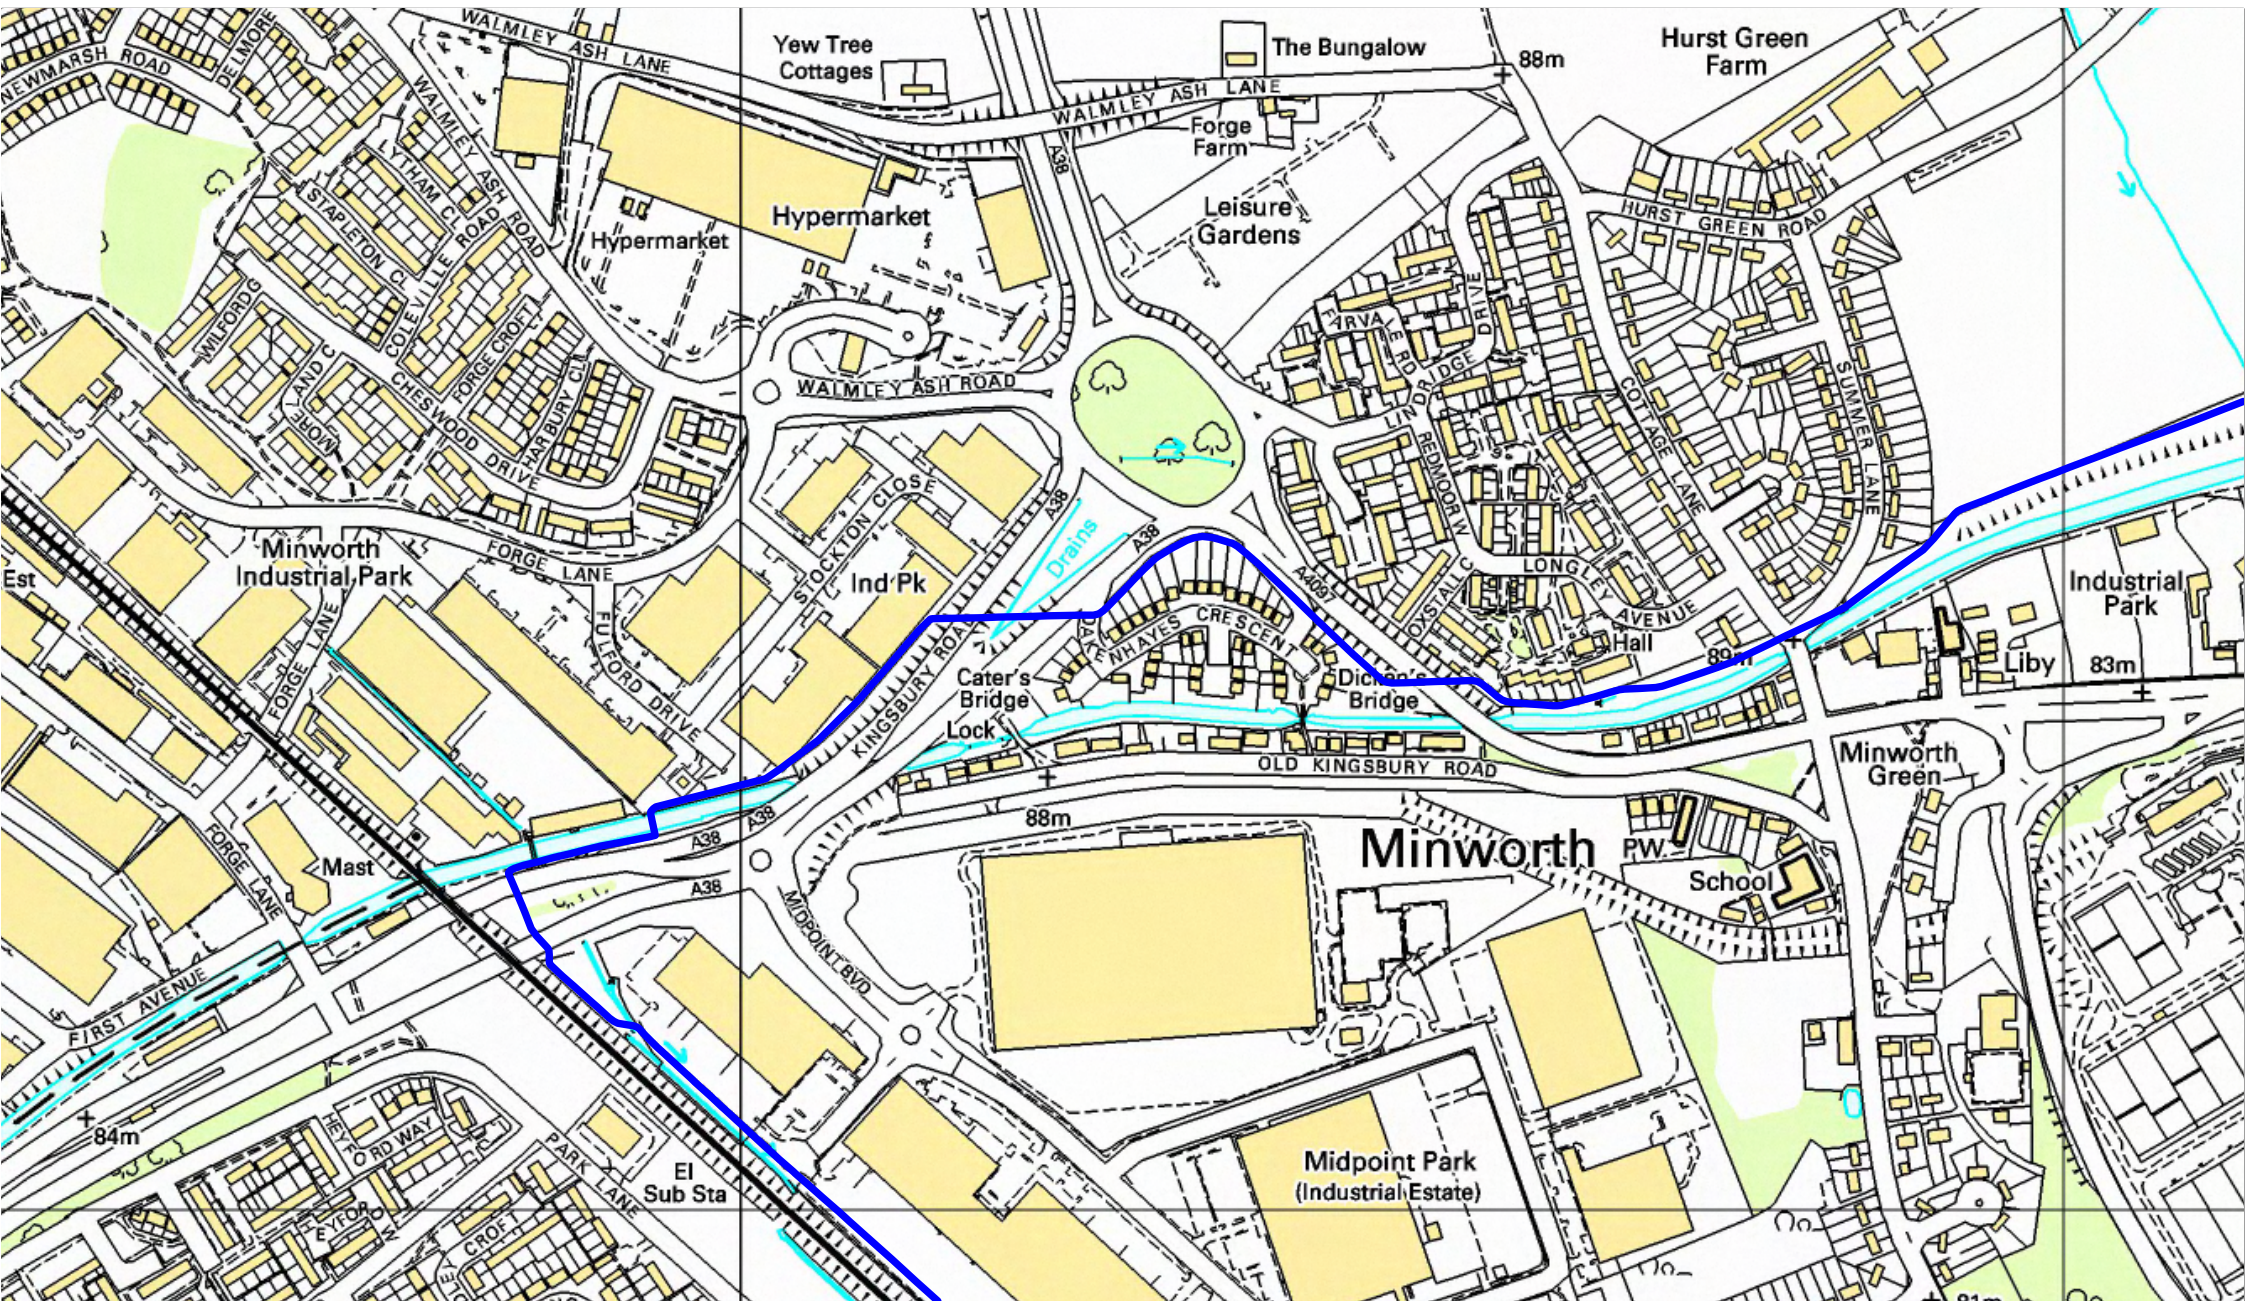

NOT TO SCALE

Date Plan Created:  
18/02/2014

Plan Centre:  
415288E,292419N

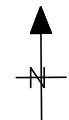

**WARNING**  
This drawing must **NOT** be used to locate the Pipe. The location of the Pipe **MUST** be verified and pegged on site by the Pipeline Operator before any excavation or disturbance of the ground near it commences, except for normal cultivation no deeper than 12" or 300mm. Please Telephone 0800 7560804 to arrange.

**MAINLINE  
PIPELINES  
LIMITED**

SEISDON TO KINGSBURY


Drawing Number:  
S\_K-20140218

Issue:  
A

**Statutory Undertaker Enquiry**

"Rainsford, Matthew R" <Matthew.Rainsford@aecom.com>


Created on 18/02/2014 11:02

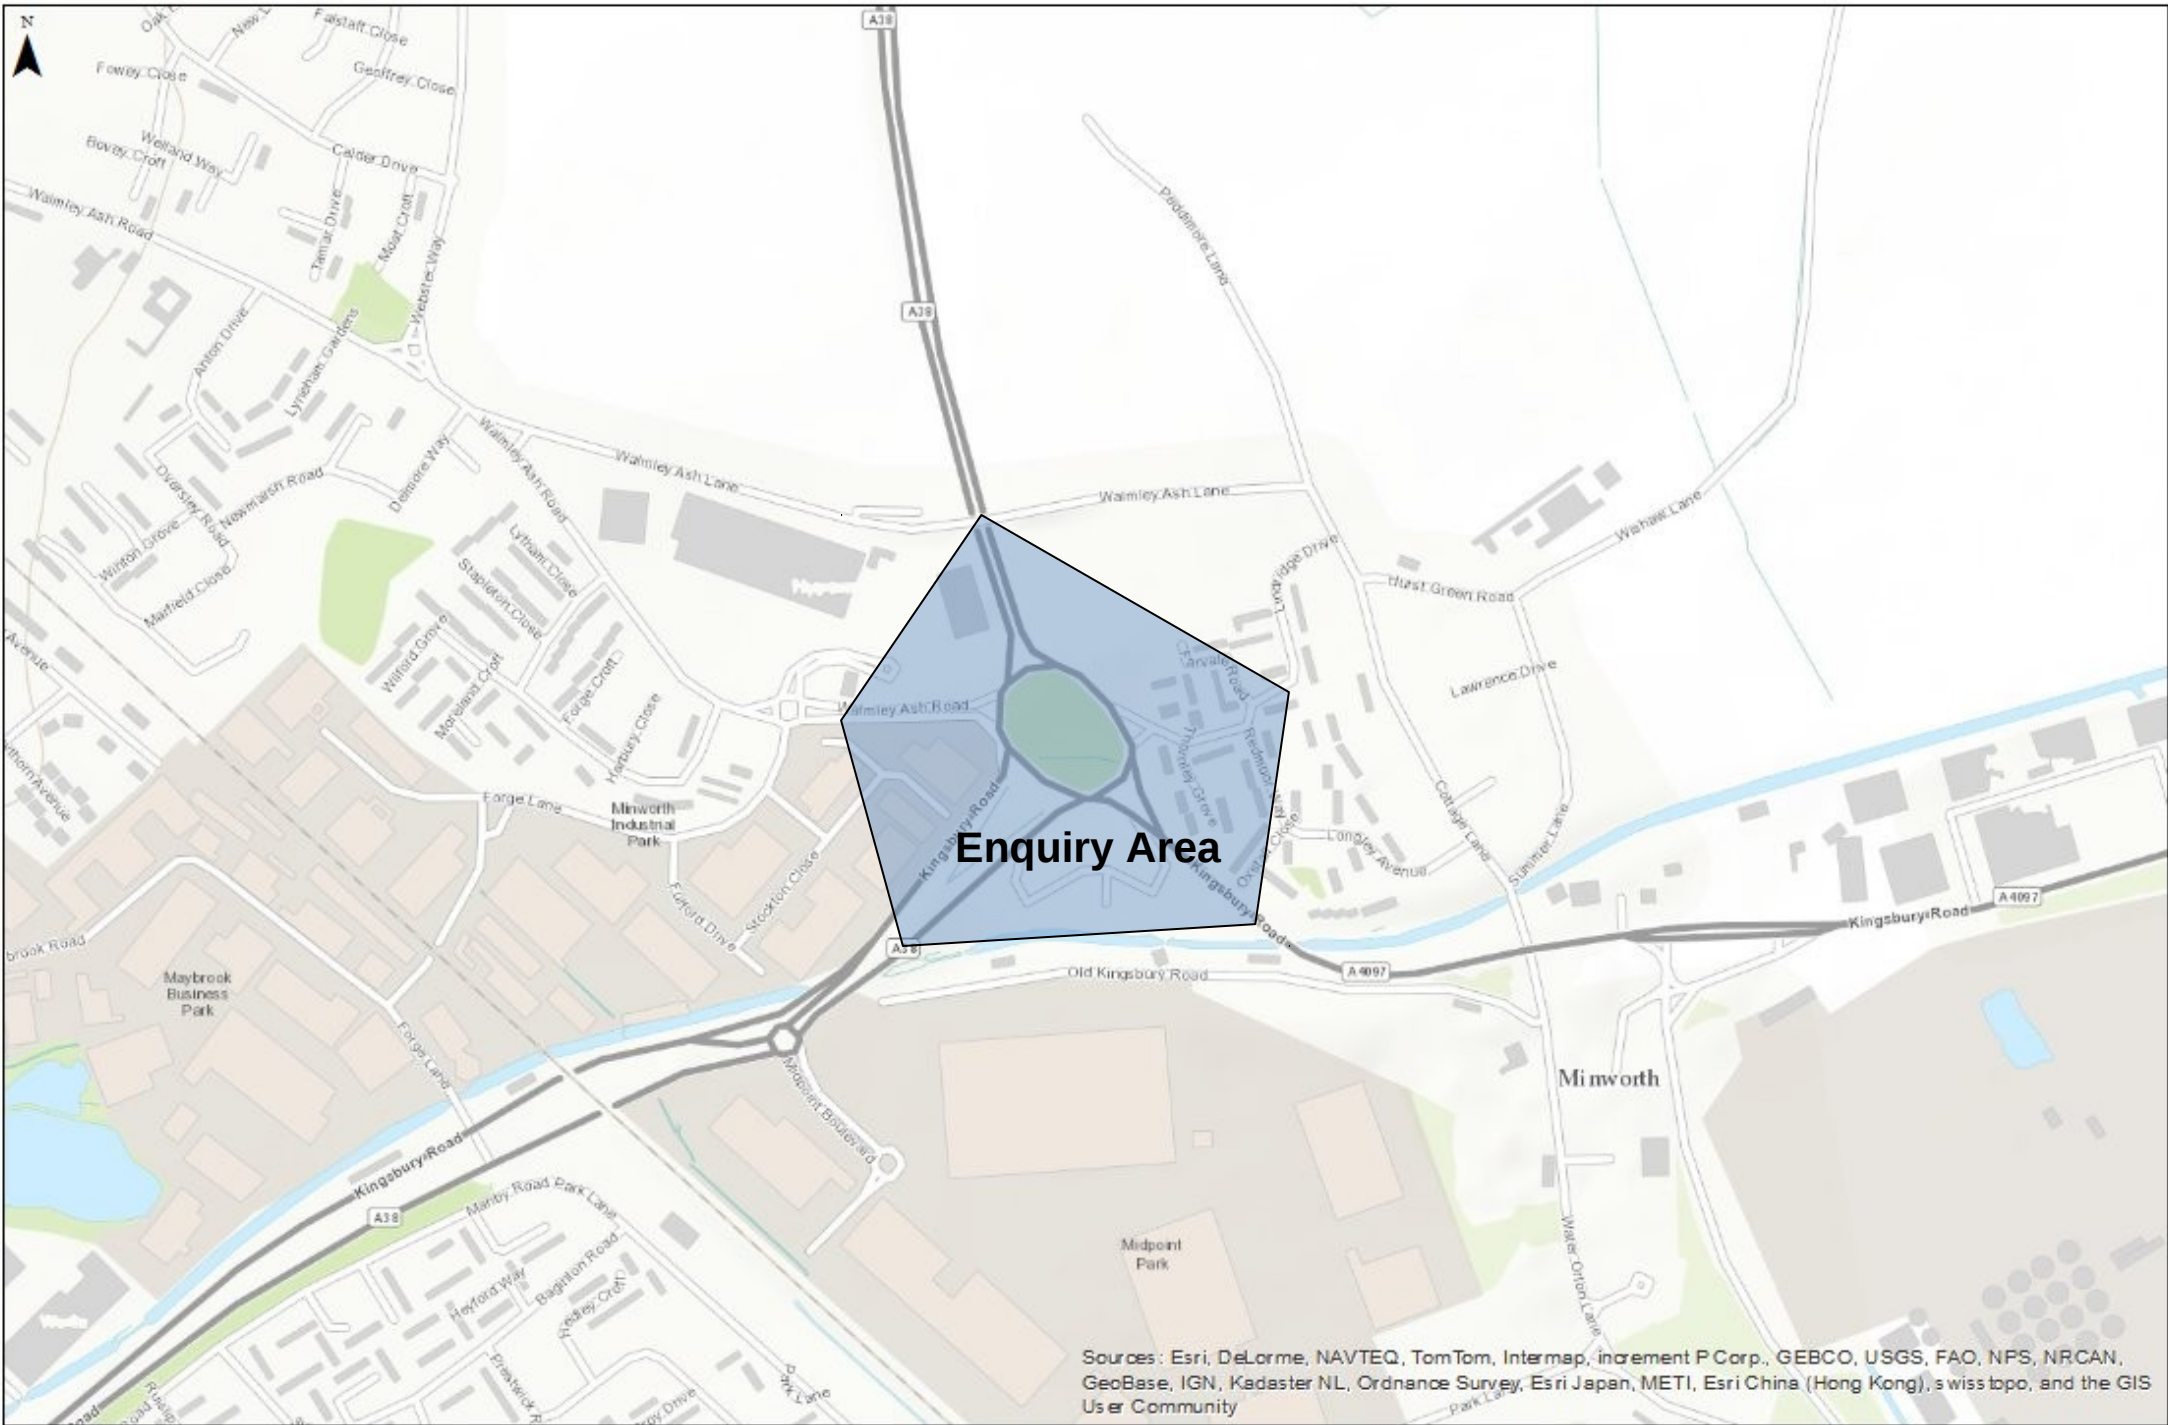


Sources: Esri, DeLorme, NAVTEQ, TomTom, Intermap, increment P Corp., GEBCO, USGS, FAO, NPS, NRCAN, GeoBase, IGN, Kadaster NL, Ordnance Survey, Esri Japan, METI, Esri China (Hong Kong), swiss topo, and the GIS User Community



SP1593NE  
 Tile not found in current owner index. Other owners' assets may be present in this area.

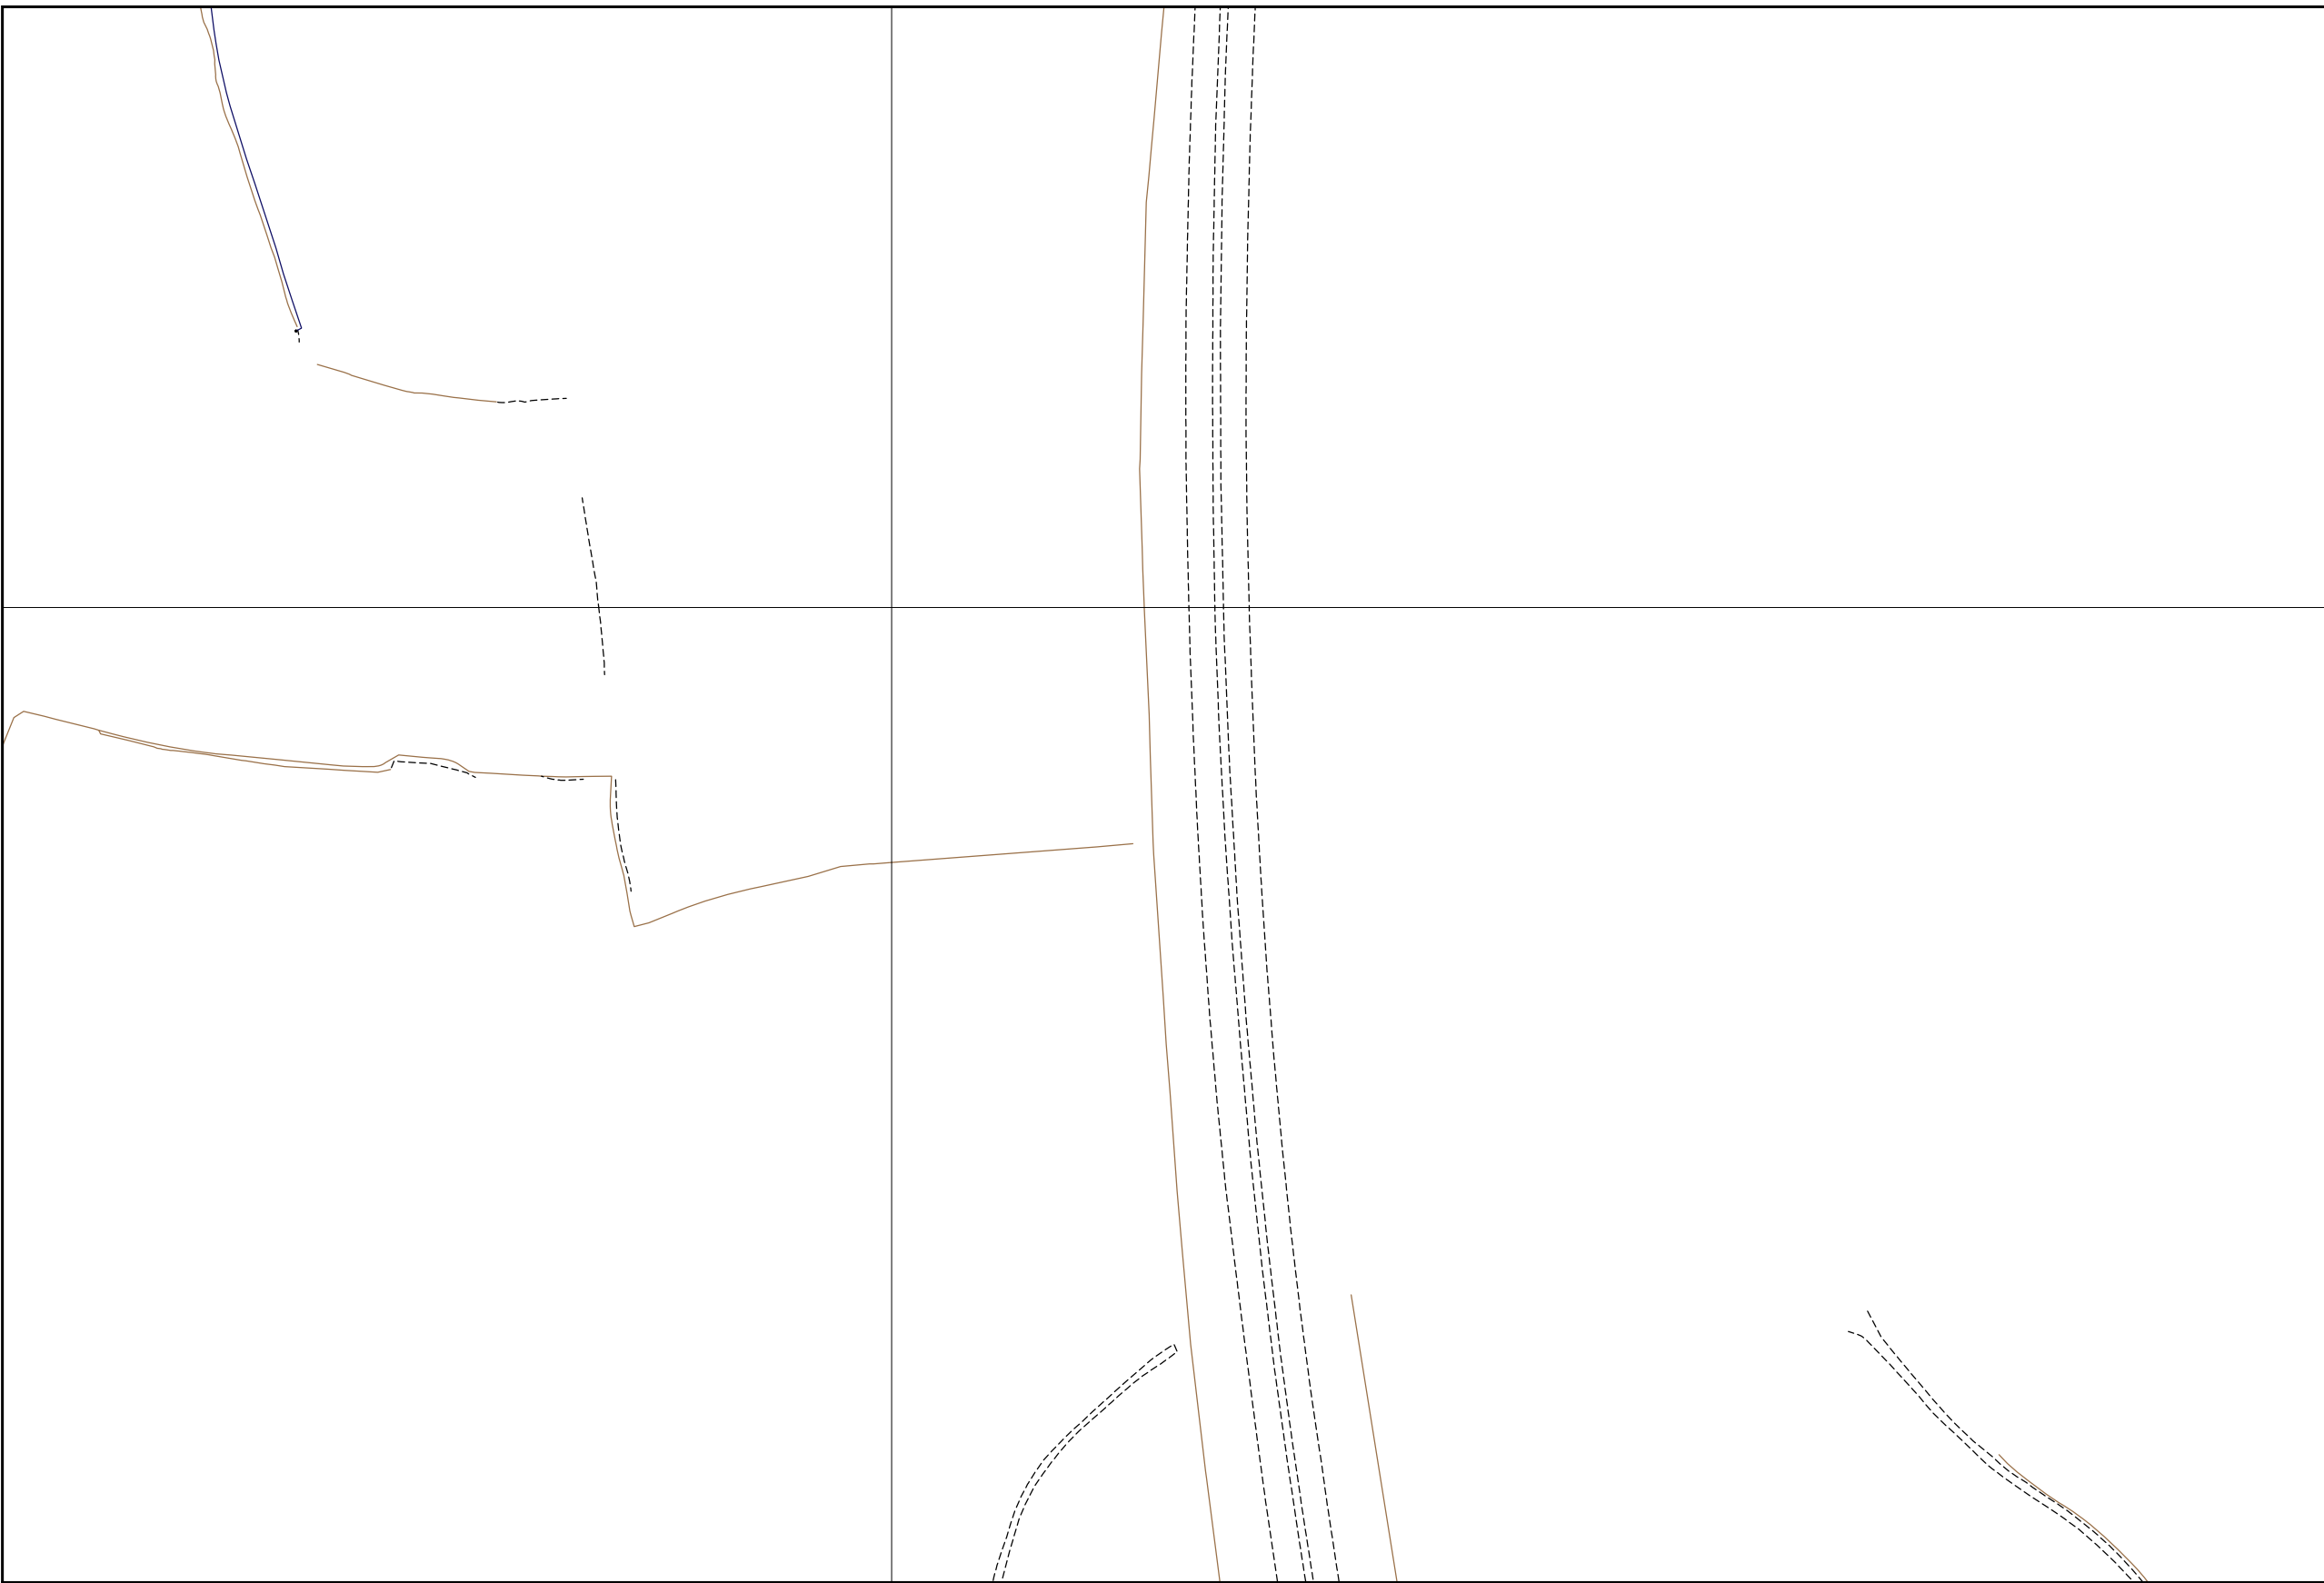

SCALE: Not to scale  
 USER ID: thom7296  
 DATE: 14/04/2014  
 EXTRACT DATE: 01/01/1970  
 MAP REF: SP1593  
 CENTRE: 415192, 293435

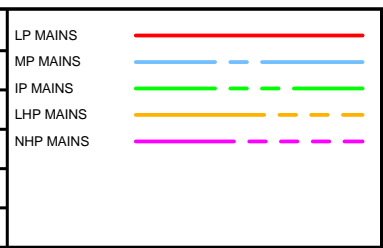


This plan shows those pipes owned by National Grid Gas plc in their role as a Licensed Gas Transporter (GT). Gas pipes owned by other GTs, or otherwise privately owned, may be present in this area. Information with regard to such pipes should be obtained from the relevant owners. The information shown on this plan is given without warranty, the accuracy thereof cannot be guaranteed. Service pipes, valves, syphons, stub connections, etc. are not shown but their presence should be anticipated. No liability of any kind whatsoever is accepted by National Grid Gas plc or their agents, servants or contractors for any error or omission. Safe digging practices, in accordance with HS(G)47, must be used to verify and establish the actual position of mains, pipes, services and other apparatus on site before any mechanical plant is used. It is your responsibility to ensure that this information is provided to all persons (either direct labour or contractors) working for you on or near gas apparatus. The information included on this plan should not be referred to beyond a period of 28 days from the date of issue. Further information on all DR4s can be determined by calling the DR4 hotline on 01455 892426 (9am-5pm) A DR4 is where a potential error has been identified within the asset record and a process is currently underway to investigate and resolve the error as appropriate.




MAPS Viewer Version 5.6.7.0  
 Local Machine  
 This plan is reproduced from or based on the OS map by National Grid Gas plc, with the sanction of the controller of HM Stationery Office. Crown Copyright Reserved.



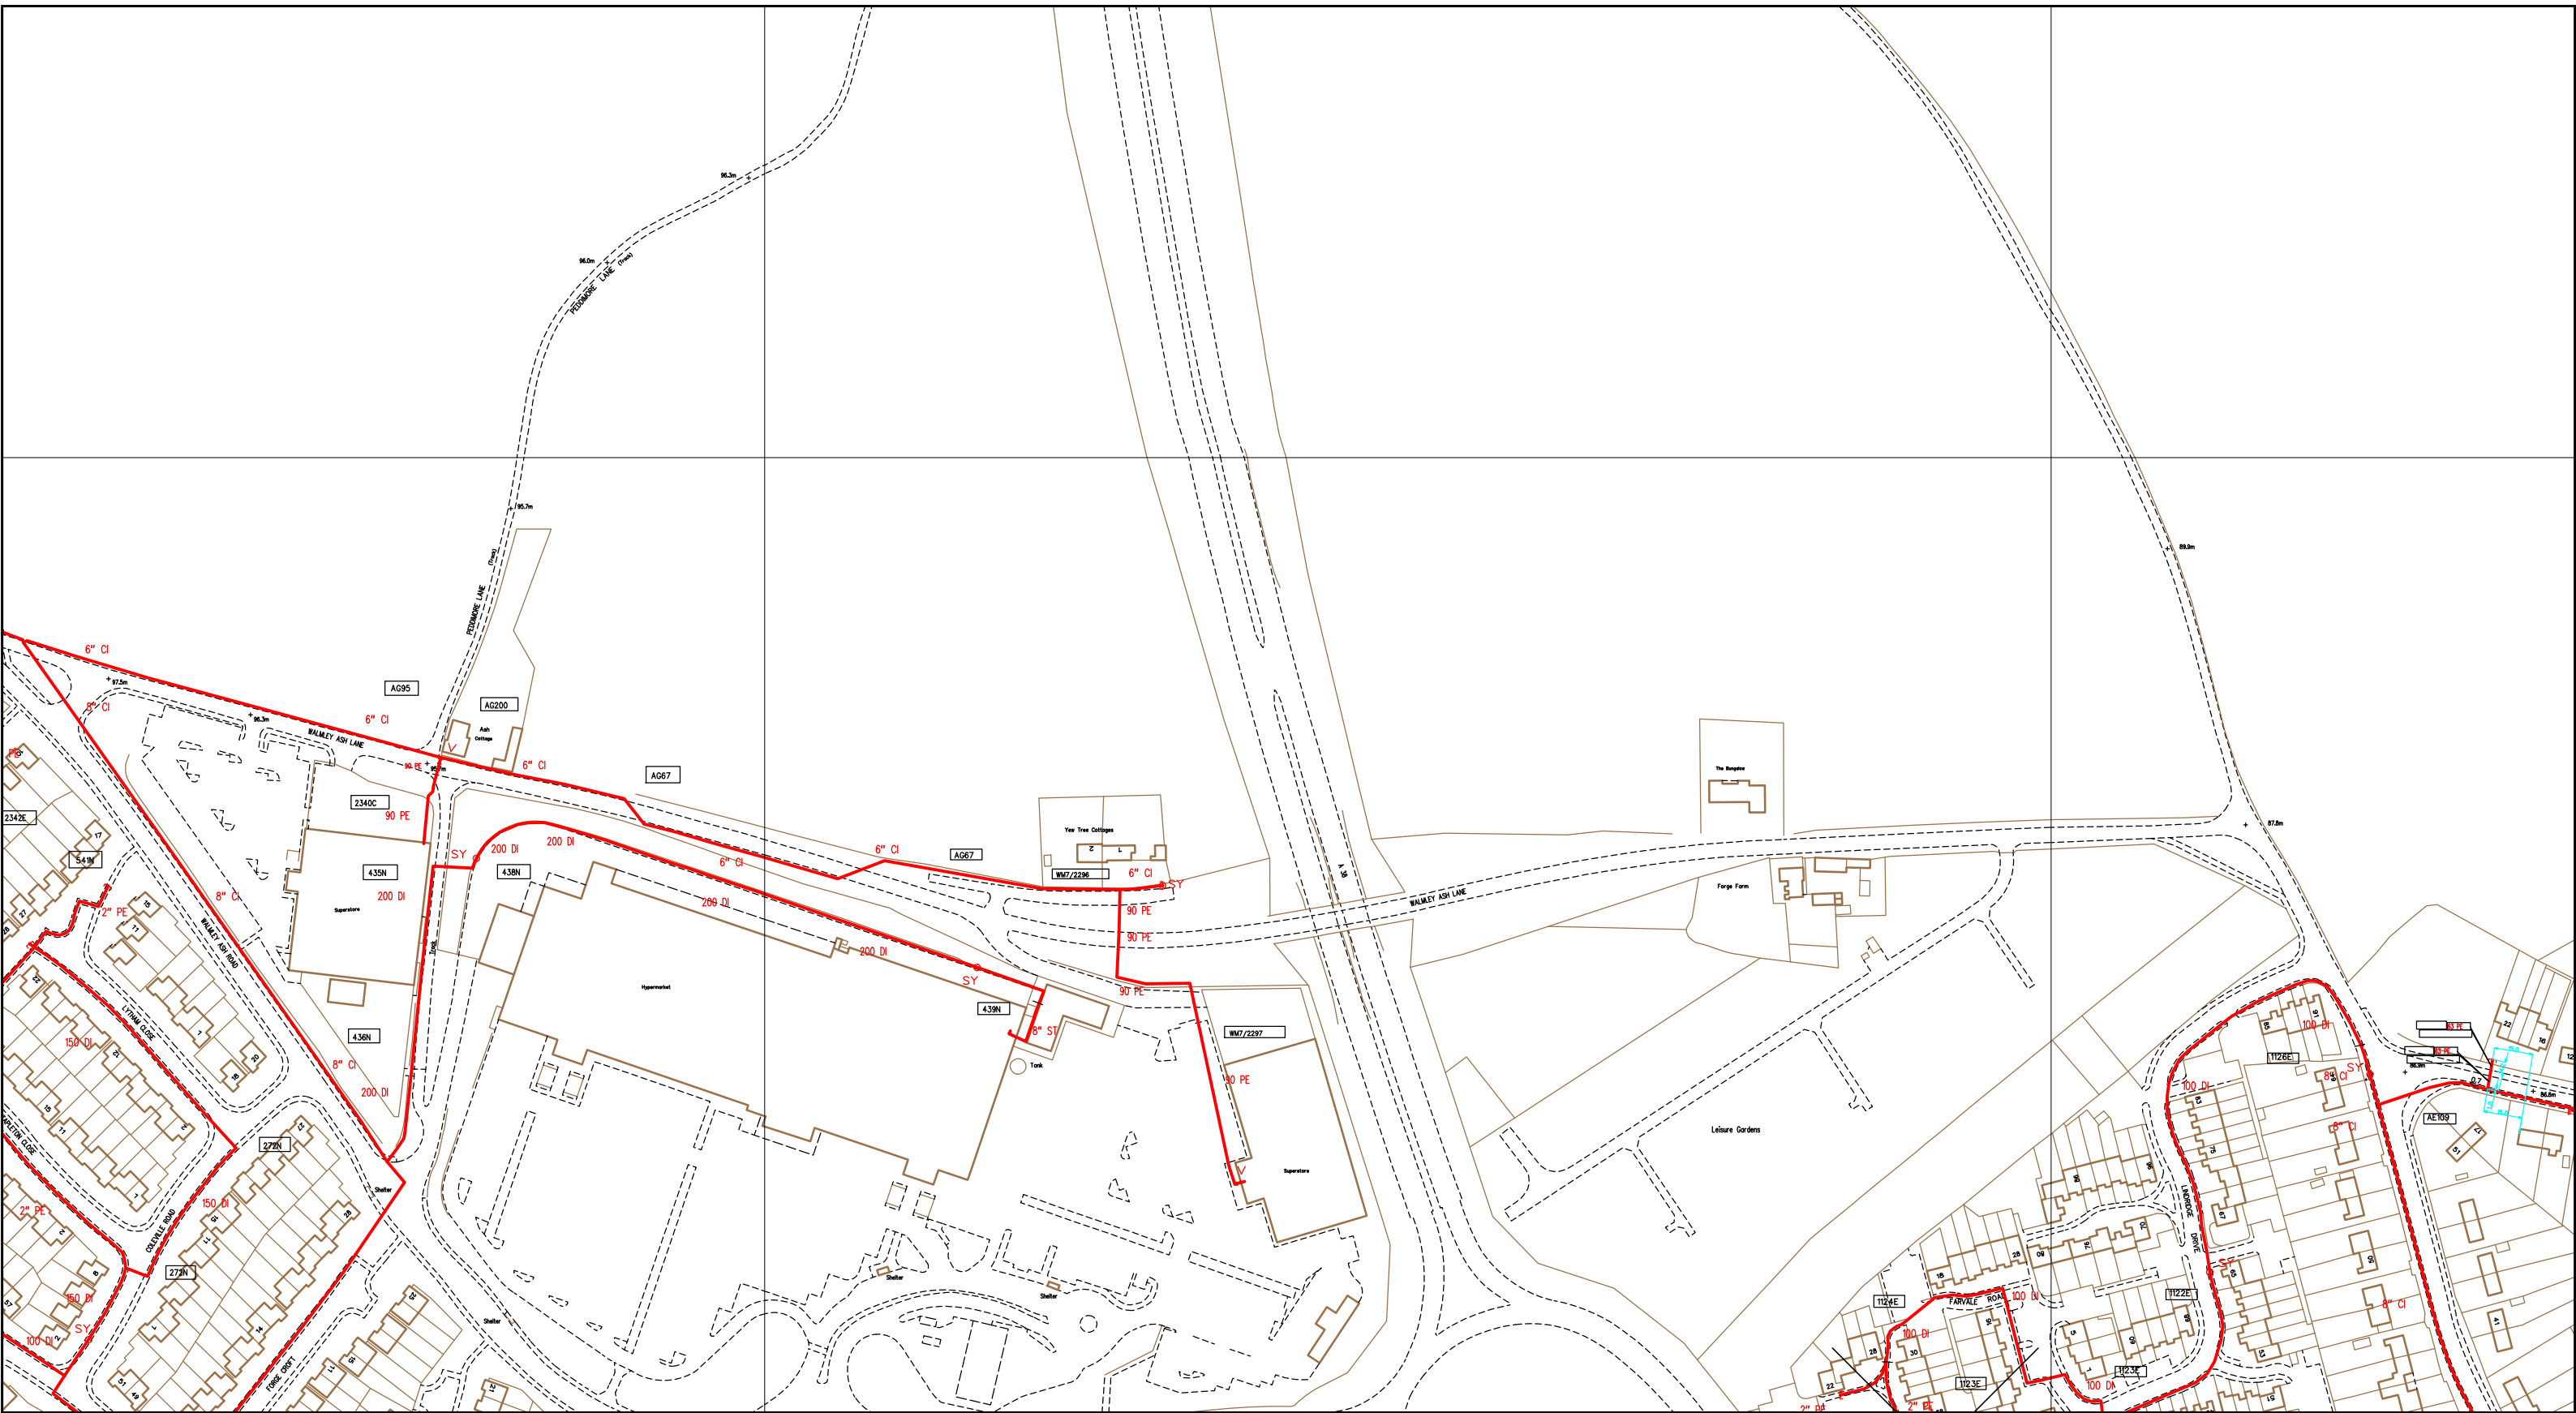

<p>SCALE: Not to scale</p> <p>USER ID: thom7296</p> <p>DATE: 14/04/2014</p> <p>EXTRACT DATE: 10/12/2013</p> <p>MAP REF: SP1592</p> <p>CENTRE: 415204, 292902</p>	<p>LP MAINS <span style="color: red;">—</span></p> <p>MP MAINS <span style="color: blue;">- - -</span></p> <p>IP MAINS <span style="color: green;">- - -</span></p> <p>LHP MAINS <span style="color: yellow;">- - -</span></p> <p>NHP MAINS <span style="color: magenta;">- - -</span></p>	<p>This plan shows those pipes owned by National Grid Gas plc in their role as a Licensed Gas Transporter (GT). Gas pipes owned by other GTs, or otherwise privately owned, may be present in this area. Information with regard to such pipes should be obtained from the relevant owners. The information shown on this plan is given without warranty, the accuracy thereof cannot be guaranteed. Service pipes, valves, syphons, stub connections, etc. are not shown but their presence should be anticipated. No liability of any kind whatsoever is accepted by National Grid Gas plc or their agents, servants or contractors for any error or omission. Safe digging practices, in accordance with HS(G)47, must be used to verify and establish the actual position of mains, pipes, services and other apparatus on site before any mechanical plant is used. It is your responsibility to ensure that this information is provided to all persons (either direct labour or contractors) working for you on or near gas apparatus. The information included on this plan should not be referred to beyond a period of 28 days from the date of issue. Further information on all DR4s can be determined by calling the DR4 hotline on 01455 892426 (9am-5pm) A DR4 is where a potential error has been identified within the asset record and a process is currently underway to investigate and resolve the error as appropriate.</p>	<p>MAPS Viewer Version 5.6.7.0</p> <p>Local Machine</p> <p>This plan is reproduced from or based on the OS map by National Grid Gas plc, with the sanction of the controller of HM Stationery Office. Crown Copyright Reserved.</p>
<p>Some examples of Plant Items:</p> <p>Valve  Depth of Cover  Syphon  Diameter Change  Material Change </p>			

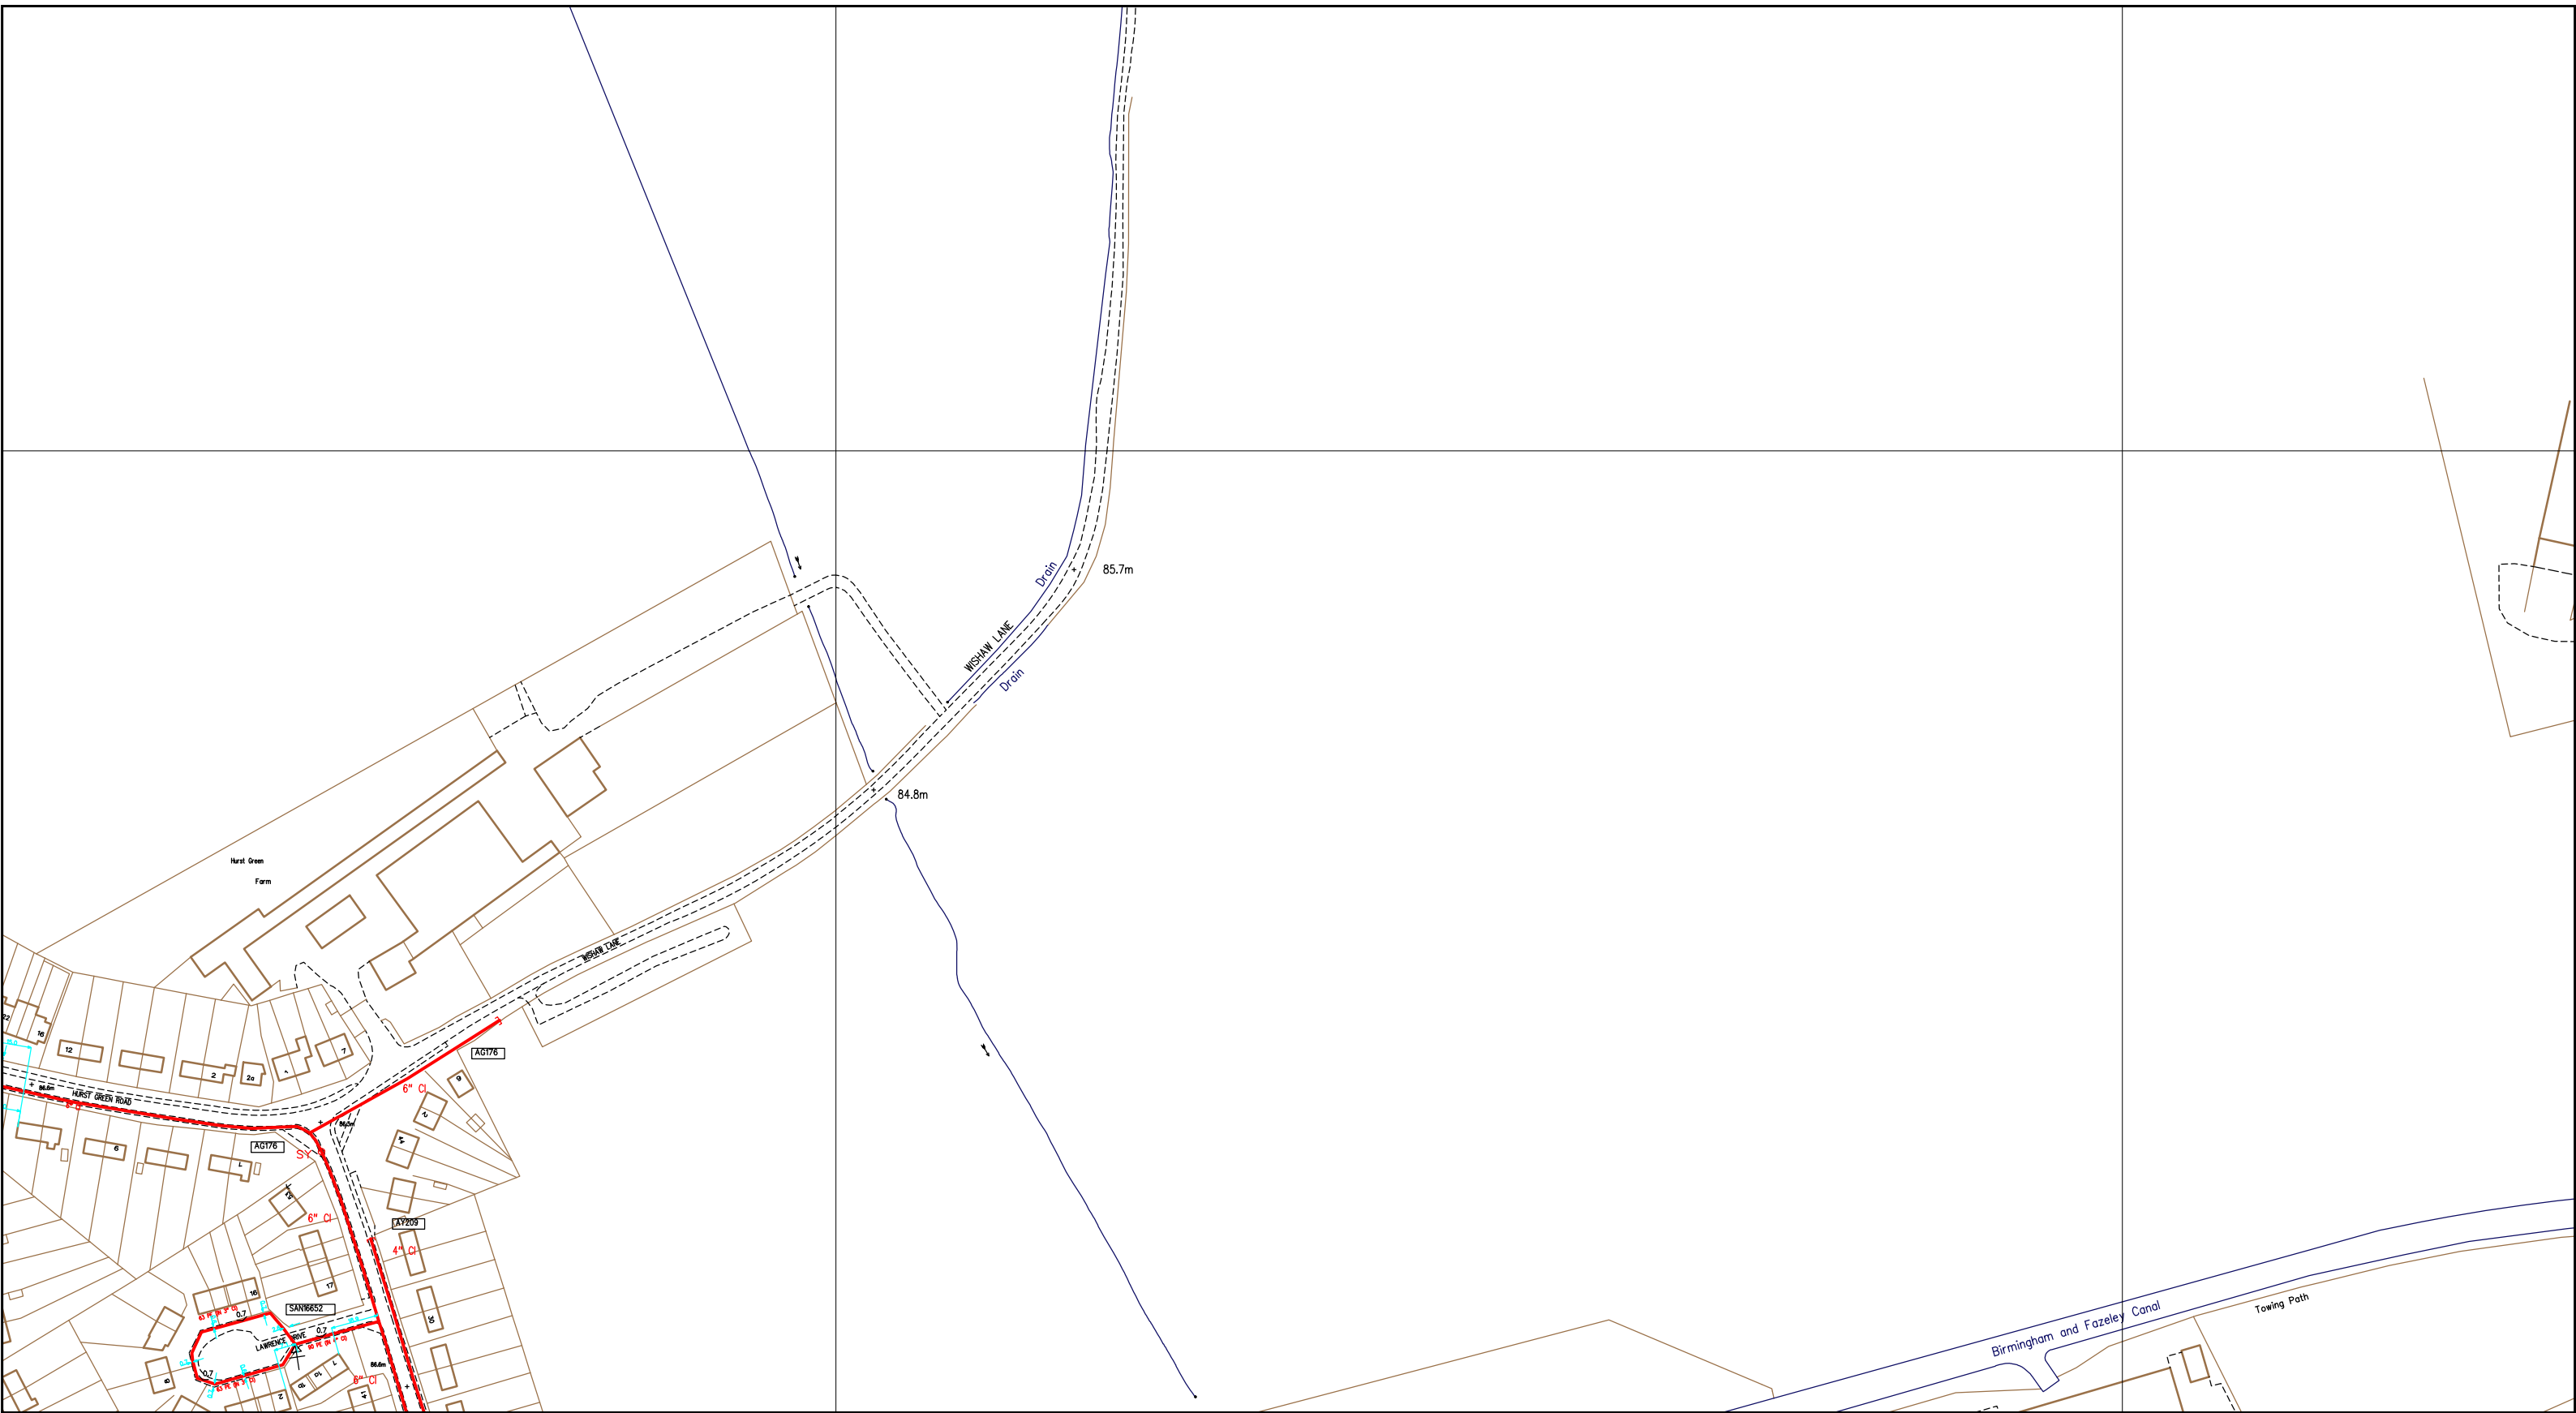

SCALE: Not to scale  
 USER ID: thom7296  
 DATE: 14/04/2014  
 EXTRACT DATE: 10/12/2013  
 MAP REF: SP1692  
 CENTRE: 416176, 292900

LP MAINS	
MP MAINS	
IP MAINS	
LHP MAINS	
NHP MAINS	

This plan shows those pipes owned by National Grid Gas plc in their role as a Licensed Gas Transporter (GT). Gas pipes owned by other GTs, or otherwise privately owned, may be present in this area. Information with regard to such pipes should be obtained from the relevant owners. The information shown on this plan is given without warranty, the accuracy thereof cannot be guaranteed. Service pipes, valves, syphons, stub connections, etc. are not shown but their presence should be anticipated. No liability of any kind whatsoever is accepted by National Grid Gas plc or their agents, servants or contractors for any error or omission. Safe digging practices, in accordance with HS(G)47, must be used to verify and establish the actual position of mains, pipes, services and other apparatus on site before any mechanical plant is used. It is your responsibility to ensure that this information is provided to all persons (either direct labour or contractors) working for you on or near gas apparatus. The information included on this plan should not be referred to beyond a period of 28 days from the date of issue. Further information on all DR4s can be determined by calling the DR4 hotline on 01455 892426 (9am-5pm) A DR4 is where a potential error has been identified within the asset record and a process is currently underway to investigate and resolve the error as appropriate.

MAPS Viewer Version 5.6.7.0  
 Local Machine  
 This plan is reproduced from or based on the OS map by National Grid Gas plc, with the sanction of the controller of HM Stationery Office. Crown Copyright Reserved.

